


Rooks

KANSAS

Section 12 Township 9 Range 17-W


Well No. 2 - McClay

Company Atlantic

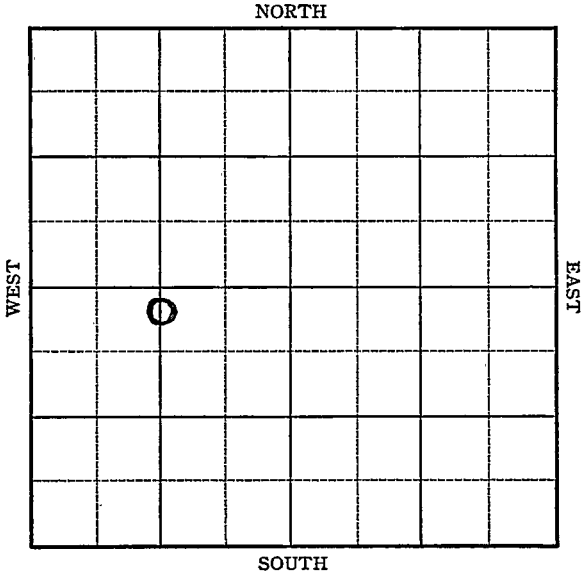

Sec. 12 Twp. 9 R. 17-WWell No. #2 McClôy Farm
Atlantic Company330 Ft. from N. Line Ft. from S. Line Ft. from E. Line1320 Ft. from W. Line

Elev. 2020

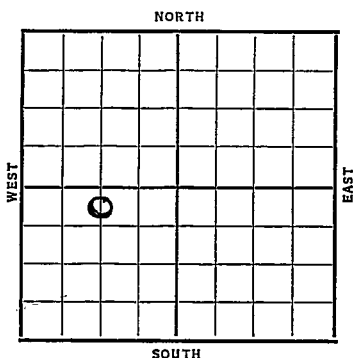

Date	REPORT
1937	
9/15	Location
9/24	"
10/2	"
10/8	"
10/15	"
10/22	"
10/29	"
11/5	"
11/12	R. R.
11/19	"
11/26	S. H.
12/3	10" @ 110'. Anhy 1265'.
	Dr1 g. 3100'.
12/10	K.C. 3125'. S.O. 3153'.
	1 bailer oil per hr. 3174-82'.
	7" @ 3142'. Dr1 g. 3200'.
	600' oil.
12/17	T.D. 3238'. Swab 11 bbls. oil
	per hour. Nat. after head.
	6000 acid.

OVER

1937

12/22 7" @ 3142'.

K.C. 3125'.

T.D. 3238'.

6000 acid.

Potential 1240 bbls.

COMPLETED

Rooks KANSAS

Map No. 64 Sec. 12 Twp. 9 R. 17WWell No. 2-McClay
Atlantic Company

Contractor

FIRST REPORT

SECTION PLAT

	0		

330 Ft. from N. Line

_____ Ft. from S. Line

_____ Ft. from E. Line

1320 Ft. from W. LineLocation ✓

Rig up _____

Drilling and Remarks:

RECORD

Cased _____ in., _____ ft.

Sand _____

Gas _____

Oil _____

Total Depth _____

PRODUCTION

1st 24 hrs. Nat. _____

1st 24 hrs. after shot _____

Gas _____ Cu. Ft.

Dry Hole _____

Abandoned _____

Date

and 115 1937
19

H. D. Hatfield Scout

Rooks . KANSAS

Map No. 64 Sec. 12 Twp. 9 R. 17WWell No. 2 McClayAtlantic Company

Contractor

COMPLETED

C N L SW

330 Ft. from N. Line

_____ Ft. from S. Line

_____ Ft. from E. Line

1320 Ft. from W. Line

SECTION PLAT

	0		

Location _____

Rig up _____

Drilling and Remarks:

6000 acidPOT-1240

RECORD

Cased 7 in., 3142 ft.Sand K.C. 3125

Gas _____

Oil _____

Total Depth 3238

PRODUCTION

1st 24 hrs. Nat. _____

1st 24 hrs. after shot _____

Gas _____ Cu. Ft.

Dry Hole _____

Abandoned _____

Date

DEC 22 1937

19

H. D. Hatfield

Scout