

Section 12 Township 9 Range 17WWell No. 3 McClayCompany C R A

Westhusin Pool

NORTH

WEST								EAST

SOUTH

Sec. 12 Twp. 9 R. 17WWell No. #3 McClay Farm

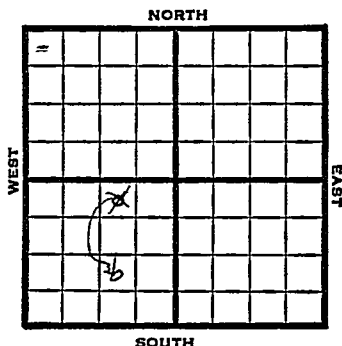
C R A

Company

Westhusin Pool

~~380~~ Ft. from N. Line990 Ft. from S. Line990 Ft. from E. Line

Ft. from W. Line

NW NE SW
SE

1949

Elev 2048' REPORT

1/5

8" @ 210'
Drlg. 1070'

1/12

Drlg 3200

1/19

Lansing 3172'
Arb. 3456-57'
TD 3457'

1/26

5" @ 3456'
TD 3459
1000 acid
Swb 1 bbls oil PH 2 hrs.

2/2

"

2/9

1000 acid
Pump 36 bbls oil 24 hrs.

2/16

"

2/23

"

3/2

TD 3466'
Arb. 3461'
5"@ 3461'
2000 acid
Pump 28 Oil Pot
37° Gr.
Comp**COMPLETED**

Kansas

Map No. _____ Sec. 12 Twp. 9 R. 17W

Well No. 3 McClay

C R A

Company

FIRST REPORT

Contractor

NW NE SW

SECTION PLAT

330 Ft. from N. Line

Ft. from S. Line

990 Ft. from E. Line

Ft. from W. Line

	a		

Rooks County

Location _____

Rig up _____

Drilling and Remarks:

8" @ 210

drlg. 1070

RECORD

Cased _____ in., _____ ft.

Sand _____

Gas _____

Oil _____

Total Depth _____

PRODUCTION

1st 24 hrs. Nat. _____

1st 24 hrs. after shot _____

Gas _____ Cu. Ft.

Dry Hole _____

Abandoned _____

Date

JAN 5 1949 19

S. J. LEWIS

Scout

~~Kansas~~

Westhusin Pool

Map No. 64 Sec. 12 Twp. 9 R. 17WWell No. 3 McClay

C R A

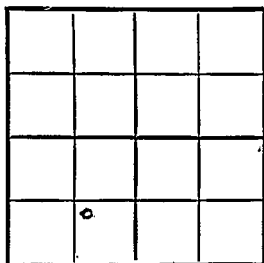
Company

CORRECTION

Contractor

NW SE SW

SECTION PLAT

 Ft. from N. Line990 Ft. from S. Line990 Ft. from E. Line Ft. from W. Line

Rooks County

RECORD

Location Cased in., ft.Rig up Sand

Drilling and Remarks:

Gas Oil Total Depth

Reported

NW NE SW

PRODUCTION

1st 24 hrs. Nat. 1st 24 hrs. after shot Gas Cu. Ft.Dry Hole Abandoned

Date

JAN 1 2 1949 19

S. J. LEWIS

Scout

Kansas

Westhusin Pool

Map No. K64 Sec. 12 Twp. 9 R. 17WWell No. 3 McClayC R A

Company

COMPLETE

Contractor

NW SE SW

E12048
SECTION FLAT Ft. from N. Line990 Ft. from S. Line990 Ft. from E. Line Ft. from W. Line

	0		

Rooks County

Location Rig up

Drilling and Remarks:

Or 834615" @ 34612000 acsPump 25 oil37 c**RECORD**Cased in., ft.Sand Gas Oil Total Depth 3466**PRODUCTION**1st 24 hrs. Nat. 1st 24 hrs. after shot Gas Cu. Ft.Dry Hole Abandoned

Date

MAR 2 1949S. J. LEWIS

Scout