

Section 12 Township 9 Range 17W

Well No. 4 McGry

Company Atlantic

Westhusin Pool

NORTH

WEST	0						EAST

SOUTH

KANSAS

Rooks
9

✓
17W

Sec. 12 Twp. R.

Well No. #4 McCry Farm

Atlantic

Westhusin Pool


330' Ft. from N. Line

Ft. from S. Line

Ft. from E. Line

330' Ft. from W. Line

NW SW

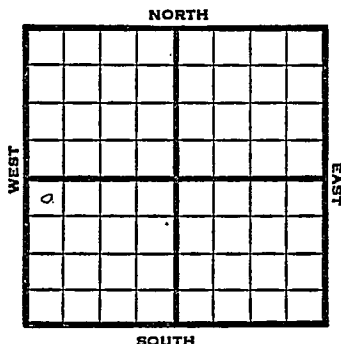

1948 Eli 2036' REPORT

11/10 10" @ 191'
11/16 Drlg. 2840'
11/23 Lansing 3151'
Arb. 3432-34'
TD 3434'
5" @ 3433'
11/30 24 shots 3430-34'
CO
12/8 1000 acid
Swb 15 bbls oil PH 3 hrs.
12/15 "
12/22 "
12/29 TD 3434'
Arb. 3432'
5" @ 3433'
24 shots 3430-34
1000 acid
Pump 340 oil / 3% W Pot
28° Gr.
Comp
COMPLETED

Map No. _____ Sec. 12 Twp. 9 R. 17W

Well No. 4 McCry

Atlantic Company

FIRST REPORT Contractor

NW SW

SECTION PLAT

330 Ft. from N. Line

_____ Ft. from S. Line

_____ Ft. from E. Line

330 Ft. from W. Line

o			

Rooks County

Location _____

Rig up _____

Drilling and Remarks:

10" @ 191

RECORD

Cased _____ in., _____ ft.

Sand _____

Gas _____

Oil _____

Total Depth _____

PRODUCTION

1st 24 hrs. Nat. _____

1st 24 hrs. after shot _____

Gas _____ Cu. Ft.

Dry Hole _____

Abandoned _____

Date

NOV 10 1948 19

S. J. LEWIS Scout

Map No. 64 Sec. 12 Twp. 9 R. 17WWell No. 4 McCryAtlantic Company

COMPLETE

Contractor

NW SW

E12086
SECTION PLAT330 Ft. from N. Line Ft. from S. Line Ft. from E. Line330 Ft. from W. Line

0			

Rooks County

Location Rig up

Drilling and Remarks:

Cor 3432.5" @ 343324 1/2 hrs to 3430-341000 @ acidProd. 3450 @ 643 7/8RT28 1/2 hrs

RECORD

Cased in., ft.Sand Gas Oil ✓Total Depth 3434

PRODUCTION

1st 24 hrs. Nat. 1st 24 hrs. after shot Gas Cu. Ft.Dry Hole Abandoned

Date

DEC 29 1948

19

S. J. LEWIS - Scout