
FORM 51 25M 3-49 PETROL KANSAS Rooks

Section 12 Township 9 Range 17W

Well No. 3 Smith

Company Plainstock

Westhusin

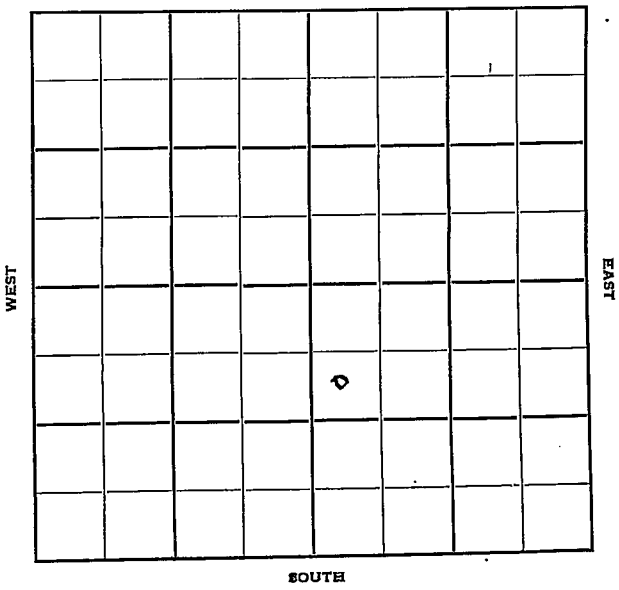

FORM .252-A
5M 10-48 PETROL

KANSAS Rooks

Sec. 12 Twp. 9 R. 17W ✓

Well No. #3 Smith Farm

Plainstock Company

Westhusin Pool


990' Ft. from N. Line

Ft. from S. Line

Ft. from E. Line

330' Ft. from W. Line

SW NW SE

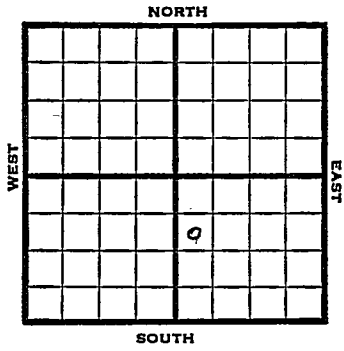

1949	Elev. 2008' REPORT
4/27	10" @ 326'
5/4	Drlg 3340'
5/10	Arb. 3423-26' TD 3426' 7"@ 3424'
5/18	TD 3428 250 acid 700' oil / 500' W 2 hrs.
5/25	"
6/1	"
6/7	"
6/15	"
6/21	"
6/28	"
7/6	"
7/12	"
7/20	"
7/27	Arb 3423' 7" @ 3424' Pump 160 oil & 20% W Pot. TD 3428' Gr. 27°

COMPLETED

Form 26 200 Bks. 9-48 Petrol

Kansas

Westhusin Pool

Map No. _____ Sec. 12 Twp. 9 R. 17W

Well No. 3. Smith

Plainstock Company

FIRST REPORT Contractor

SW NW SE


990 Ft. from N. Line

_____ Ft. from S. Line

_____ Ft. from E. Line

330 Ft. from W. Line

SECTION PLAT

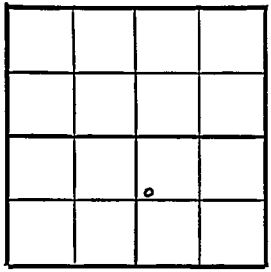

Rooks County

Location _____

Rig up _____

Drilling and Remarks:

10" @ 326

RECORD

Cased _____ in., _____ ft.

Sand _____

Gas _____

Oil _____

Total Depth _____

PRODUCTION

1st 24 hrs. Nat. _____

1st 24 hrs. after shot _____

Gas _____ Cu. Ft.

Dry Hole _____

Abandoned _____

Date

APR 27 1949 19 S. J. LEWIS Scout

Form 26 200 Bks. 6-49 Petrol-

Kansas Westhusin Pool

Map No. K64 Sec. 12 Twp. 9 R. 17W

Well No. 3 Smith


Plainstock Company

COMPLETE Contractor

SW NW SE

E 1,200 ft.

SECTION PLAT

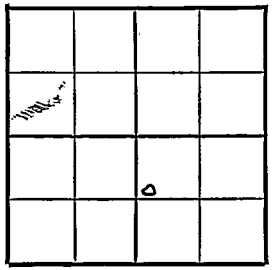

990 Ft. from N. Line

____ Ft. from S. Line

____ Ft. from E. Line

330 Ft. from W. Line

Rocks County

Location

Rig up

Drilling and Remarks:

Ce X 3423

7" @ 3424

Pump 160 oil + 20%

WBX.

27 - Ge

RECORD

Cased ____ in., ____ ft.

Sand

Gas

Oil

Total Depth 3428

PRODUCTION

1st 24 hrs. Nat.

1st 24 hrs. after shot

Gas ____ Cu. Ft.

Dry Hole

Abandoned

Date

JUL 27 1949 19

S. J. LEWIS Scout