


Section 12 Township 9 Range 19-W

Well No. #3 Hilgers

Company Skelly


9

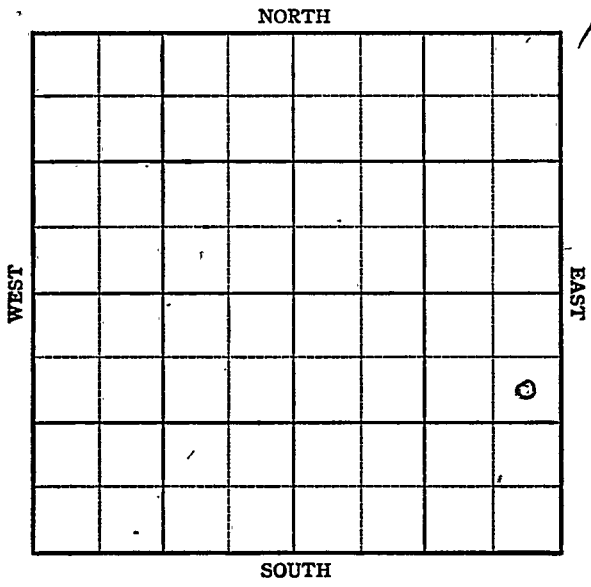

Sec. 12 Twp. 9 R. 19-W

Well No. #3 Hilgers Farm
Skelly Company
Barry Pool

990 Ft. from N. Line
 Ft. from S. Line
330 Ft. from E. Line
 Ft. from W. Line

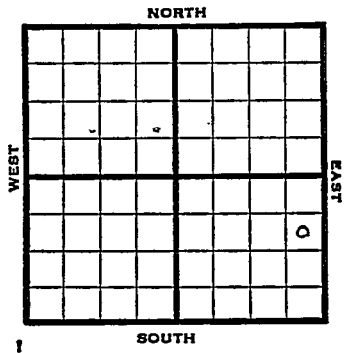

SE NE SE Elev. 2073'

REPORT

1947

- 3/12 Location
- 3/18 Derrick
- 3/25 R U R
- 4/2 13" @ 200'
WOC
- 4/9 8" @ 1432
Anhy 1427
Drlg 2650'
- 4/15 Lansing 3242'
Arbuckle 3485'
TD 3490'
5" @ 3486'
RUST
- 4/23 LSM 3490-3485
Lans 3237
Arb 3480
5" @ 3481'
TD 3489'
2542' oil in 12 hrs

VER

4/30 Arb 3480
5" @ 3481'
500 Acid
Depth Pot 16,194
Wax 3000
Grav. 27.5
TD 3489'

COMPLETED

Kansas

Map No. 65 Sec. 12 Twp. 9 R. 19W

Well No. 3 Hilgers

Skelly Company

FIRST REPORT Contractor

SE NE SE

SECTION PLAT

990 Ft. from N. Line

_____ Ft. from S. Line

330 Ft. from E. Line

_____ Ft. from W. Line

			a

Rooks County

Location X

Rig up _____

Drilling and Remarks:

RECORD

Cased _____ in., _____ ft.

Sand _____

Gas _____

Oil _____

Total Depth _____

PRODUCTION

1st 24 hrs. Nat. _____

1st 24 hrs. after shot _____

Gas _____ Cu. Ft.

Dry Hole _____

Abandoned _____

Date

MAR 12 1947 19

S. J. LEWIS Scout

Kansas

Map No. 65 Sec. 12 Twp. 9 R. 19W

Well No. 3 Hilgers

Skelly Company

COMPLETE

Contractor

E. J. 2073

SE NE SE

SECTION PLAT

990 Ft. from N. Line

_____ Ft. from S. Line

330 Ft. from E. Line

_____ Ft. from W. Line

Rooks County

Location _____

Rig up _____

Drilling and Remarks:

Cur 3480
5' @ 3481
500 acid
Sept 16 1944
May 3000
27 5/8

RECORD

Cased _____ in., _____ ft.

Sand _____

Gas _____

Oil _____

Total Depth 3489

PRODUCTION

1st 24 hrs. Nat. _____

1st 24 hrs. after shot _____

Gas _____ Cu. Ft.

Dry Hole _____

Abandoned _____

Date

APR 30 1947 19

S. J. LEWIS Scout