


Section 12 Township 9 Range 19W

Well No. 4 Hilgers

Company Skelly

15

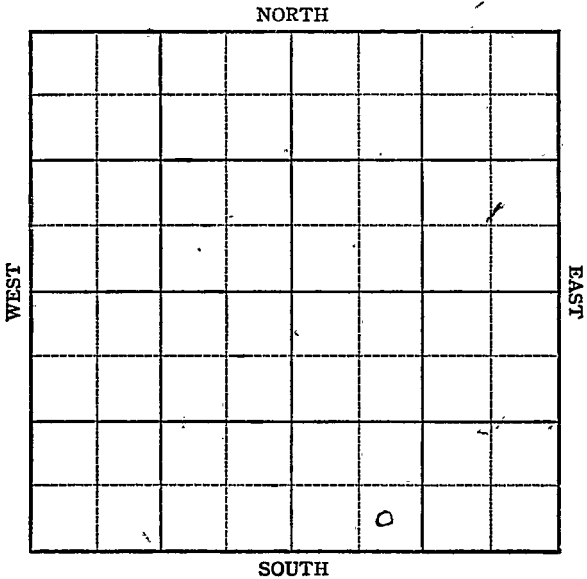

KANSAS

Rooks ✓

Sec. 12 Twp. 9 R. 19-W

Well No. #4 Hilgers Farm

Skelly Company


Barry Pool

 Ft. from N. Line

330 Ft. from S. Line

 Ft. from E. Line

990 Ft. from W. Line

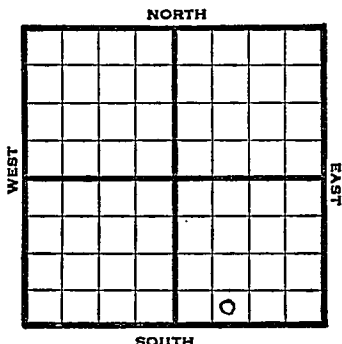

SE SW SE

1947

Elev. 2070' REPORT

4/16

Location

4/23

13" @ 208'
Drlg 1270'

4/29

8" @ 1348'
Drlg. 3268'

5/7

Lens 3234
Arb 3480-82
TD 3482'
5" @ 3488
RUST.

5/14

Arb. 3478'
5" @ 3478'
500 Acid
Echo Pot 3000
TD 3485'
27.5 Gr.

COMPLETED

Map No. 65 Sec. 12 Twp. 9 R. 19W

Well No. 4 Hilgers

Skelly Company

FIRST REPORT Contractor

SE SW SE


SECTION PLAT

 Ft. from N. Line

330 Ft. from S. Line

 Ft. from E. Line

990 Ft. from W. Line

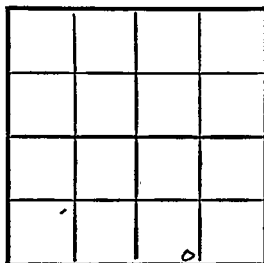

Rooks County

Location X

Rig up

Drilling and Remarks:

RECORD

Cased in, ft.

Sand

Gas

Oil

Total Depth

PRODUCTION

1st 24 hrs. Nat.

1st 24 hrs. after shot

Gas Cu. Ft.

Dry Hole

Abandoned

Date

APR 16 1947 19 S. J. LEWIS Scout

Map No. K65 Sec. 12 Twp. 9 R. 19W

Well No. 4 Hilgers

Skelly Company

COMPLETE

Contractor

SE SW SE

E12020
SECTION PLAT

 Ft. from N. Line

330 Ft. from S. Line

 Ft. from E. Line

990 Ft. from W. Line

Rooks County

Location

Rig up

Drilling and Remarks:

Ce 3478

5" @ 3478

500 @ 3478

Ec 1st 3000

275 ft

RECORD

Cased in., ft.

Sand

Gas

Oil

Total Depth 3478

PRODUCTION

1st 24 hrs. Nat.

1st 24 hrs. after shot

Gas Cu. Ft.

Dry Hole

Abandoned

Date

MAY 14 1947

19

S. J. LEWIS

Scout

O. W. P. B

FORM 513 SUNRA

County Rooks Elev. 2070 DF
 Sec. 12 Twp. 9 Rgs. 19W
 Company Skelly Oil Co.
 FarmName Hilgers No. 4

TOPS	DEPTH	LOG	DATUM	Loc. in Sec.
Anh.				SE SW SE
T.P.				(OWPB)
H.				
Tr.				
Dg.				
BL.				
L.	3234			Geol.
K.C.				Contr.
B.K.C.				
Ce.				
C.				
M.				Pool
M.				Barry SE
K.				
Mz.				
Mq.				
V.				
S.				FIRST REPORT
S.				COMPLETE
A	3480			
R.				
Pe.				
G.				
TD	OTD 3485			

Date Comm. 5" @ 3478

New Info - PB 3441, 72/3402-14, 500A, Swb 2
 bo + 82 bw 14 hrs. PB 3340, 48/3316-24, 500A
 S/4 bo + 250 bw 12 hrs. PB 3308, 30/3296-3301,
 500A S/220 bo + 45 bw 13 hrs. P/245 bo * 45
 bw 13 hrs. P/245 bo + 24 wtr 24 hrs. Lans.
 3296-3301 COMPLETED