
FORM 51 25M 8-50 WESTERN KANSAS Rooks

Section 12 Township 9 Range 19-W

Well No. #2 Jelinek

Company Harbar Drlg.

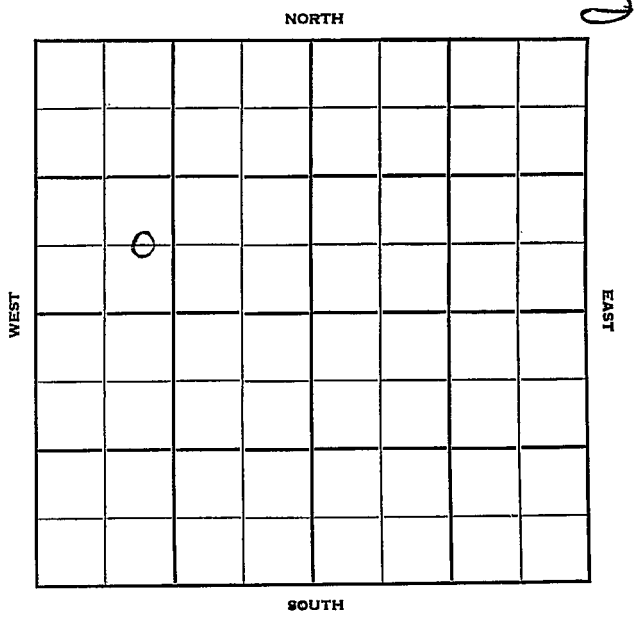

FORM 252-B
10M 10-50 PETROL

KANSAS

Rooks

Sec. 12 Twp. 9 R. 19-W

Well No. #2 Jelinek Farm

Harbar Drlg. Company

Harbar Drlg. Contractor

Berry


Ft. from N. Line

660 Ft. from S. Line

Ft. from E. Line

990 Ft. from W. Line

C EL SW NW

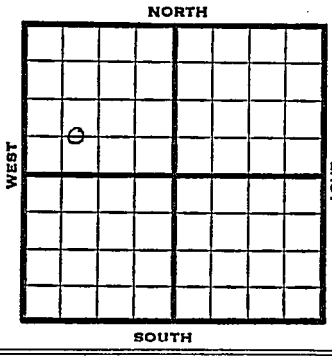

1950	Elev 2045 REPORT
11/8	Spud 11-2-50 8" @ 160 Anhy 1570 Drlg 1625
11/22	Spud 11-2-50 D&A TD 3518 8" @ 160' Anhy 1570' Lans. 3246' Heeb 3200 Toronto 3220' KC 3244' DST 3423-73 opn ½ hr Rec. 5' mud Cong. 3496-3518 TD D&A **ABANDONED**

FORM 275 FOR SALE-BY-KANSAS BLUE PRINT CO.


County Rooks State Kansas

Sec. 12 (Blk. Twp.) 9 (Sur. Rge.) 19W Map No.

Operator Harbar Drlg.

Well No. 2 Farm Jelinek

Elev. 2045 Location C EL SW NW

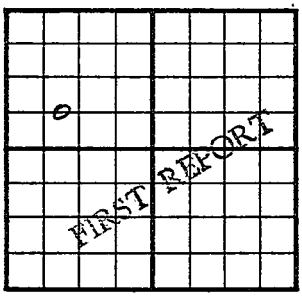

660 Ft. From S Line NW

990 Ft. From W Line Quarter

1st. Report NOV 8 1950

Completion

Remarks

Harbar Drlg. - Contr.

Spudding Date 11-2-50

Drlg. Data Berry Pool

8" @ 160 Anhy 1570 drlg. 1625

J. E. TYRA

FORM 275 FOR SALE BY KANSAS BLUE PRINT CO.


County Rooks State Kansas

Sec. 12 (Blk. Twp.) 9 (Sur. Rge.) 19W Map No.

Operator Harbar Drlg.

Well No. 2 Farm Jelinek

Elev. 2045 Location C E L SW NW

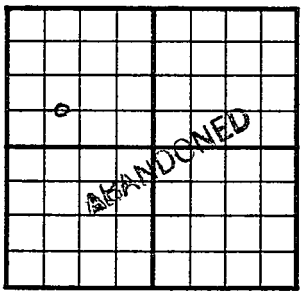

660 Ft. From S Line NW

990 Ft. From W Line Quarter

1st. Report

Completion NOV 2 2 1950

Remarks Berry Pool

Harbar Drlg. - Contr.

Spudding Date 11-2-50

Drlg. Data D & A TD 3518

8" @ 160 Anhy 1570 Lans. 3246

Heeb. 3200 Toronto 3220 KC 3244

DST 3423-73 open ½ hr. Rec. 5' mud

Cong. 3496-3518 TD D & A

J. E. TYRA