

KANSAS

Graham

Section 12 Township 9 Range 21W

Well No. 1 Eichman

Company D.G. Hansen

Wildcat
NORTH

WEST

EAST

SOUTH

16

0

Graham KANSAS ✓

Sec. 12 Twp. 9 R. 21W

Well No. #1 Eichman Farm

D. G. Hansen Company

Wildcat

 Ft. from N. Line

330'


 Ft. from S. Line

330'

 Ft. from E. Line

 Ft. from W. Line

SE/C

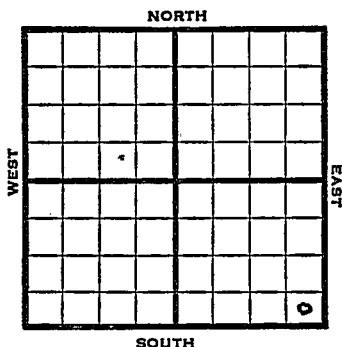

1949

Elev 2167'

R E P O R T

8/31

10" @ 195'

9/7

Lansing 3408'

Drlg. 3558'

9/14

TD 3773'

Cong 3685'

Arb. 3762'

Aband.

ABANDONED

Kansas

Map No. _____ Sec. 12 Twp. 9 R. 21W

Well No. I Eichman

A. G. Hansen Company

Contractor

SE/C


FIRST REPORT
SECTION PLAT

_____ Ft. from N. Line

330 Ft. from S. Line

330 Ft. from E. Line

_____ Ft. from W. Line

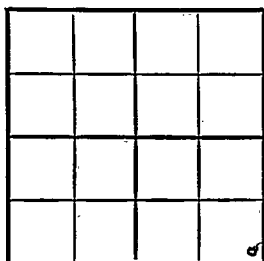

Graham County

Location _____

Rig up _____

Drilling and Remarks:

10" @ 195

RECORD

Cased _____ in., _____ ft.

Sand _____

Gas _____

Oil _____

Total Depth _____

PRODUCTION

1st 24 hrs. Nat. _____

1st 24 hrs. after shot _____

Gas _____ Cu. Ft.

Dry Hole _____

Abandoned _____

Date

AUG 31 1949 19 S I LEWIS Scout

Kansas

Wildcat

Map No. K65 Sec. 12 Twp. 9 R. 21WWell No. 1 Eichman

D. G. Hansen

Company

ABANDONED

Contractor


SE/C

E1.2167
SECTION PLAT

_____ Ft. from N. Line

330 Ft. from S. Line330 Ft. from E. Line

_____ Ft. from W. Line

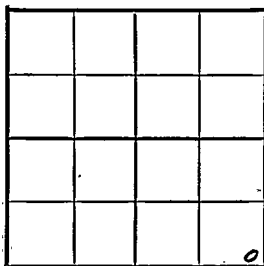

Graham County

Location _____

Rig up _____

Drilling and Remarks:

Comp 3685
Ar 83762.

RECORD

Cased _____ in., _____ ft.

Sand _____

Gas _____

Oil _____

Total Depth 3723

PRODUCTION

1st 24 hrs. Nat. _____

1st 24 hrs. after shot. _____

Gas _____ Cu. Ft.

Dry Hole _____

Abandoned _____

Date

SEP 14 1949 19

S. J. LEWIS Scout