


Graham

KANSAS

SECTION 12 TOWNSHIP 9 RANGE 22W

WELL NO. #2 Hedge

COMPANY Leo Wentworth

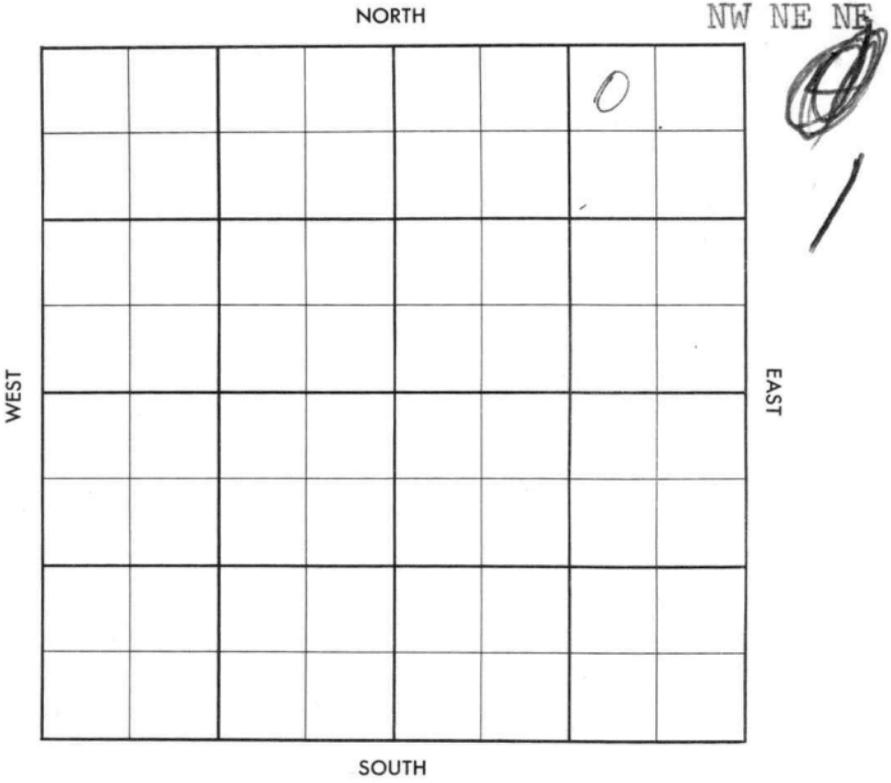


County Graham Elev. \_\_\_\_\_  
 Sec. 12 Twp. 9 Rge. 22W  
 Company Leo Wentworth  
 Farm Name Hedge No. 2

TOPS	DEPTH	LOG	DATUM
Anh.	1748		
Tr.			
Dg.			
Bl.			
L.			
K.C.			
B.K.C.			
Ce.			
C.			
M.			
M.			
K.			
Mz.			
Me.			
V.			
S.			
S.			
A.			
R.			
PE.			
G.			
T.D.			

Loc. in Sec. NW NE NE  
 Geol. \_\_\_\_\_  
 Contr. \_\_\_\_\_  
 Co. Tools  
 Pool Van  
 Cooper  
 0  
 FIRST REPORT  
 MAY 8 57

Date Comm. 4-28-57  
8" @ 238/150, Drlg. 2763

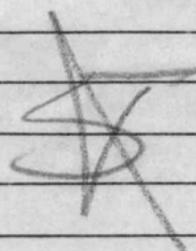

Co.  
Lse.  
No.  
Sec.  
T.  
R.



488 3812-29  $\frac{1}{2}$  300 wtr PB 3640, 16¢  
3602-06 8 \$ 3612-14 50  $\frac{1}{2}$  \$ 10 B & P P  
No X B No inc PoP D Bo 10 BW / 4 hrs  
To Rowan K

Lans 3602-14

PB 3640

12-9-22

nr nr nr