

Section 12 Township 9 Range 22-WWell No. #1 ThyfaultCompany Pickrell Drlg

NORTH

9

							0

SOUTH

WEST

EAST

Graham
9

KANSAS
22W

Sec. 12 Twp. R.

Well No. #1 Thyfault Farm

Pickrell Drlg. Company

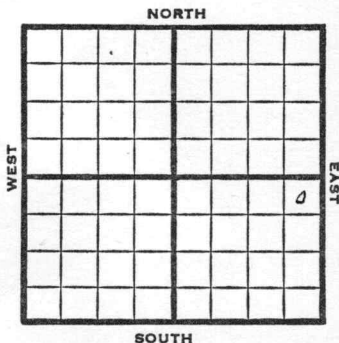
Contractor

330' Ft. from N. Line

Ft. from S. Line

330' Ft. from E. Line

Ft. from W. Line



NE NE SE

1950

Elev 2270'

REPORT

3/1

Spud 2-26-50
8-5/8" @ 151'
Drlg.

3/8

TD 3883
8 5/8" @ 151
Topeka 3248'
Heeb 3464'
Dodge 3487'
Lans 3502'
Arb 3843'
D&A
Aband.

ABANDONED

Kansas

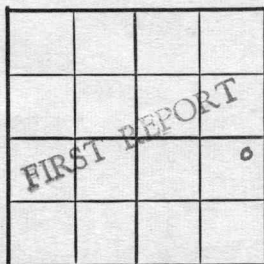
Map No. _____ Sec. 12 Twp. 9 R. 22WWell No. 1 ThyfaultPickrell Drlg.

Company _____

Contractor _____

NE NE SE

SECTION PLAT

330 Ft. from N. Line

_____ Ft. from S. Line

330 Ft. from E. Line

_____ Ft. from W. Line

Graham County

Atlantic & Lion DHM

Location _____

Rig up _____

Drilling and Remarks:

Spud 2-26-50

8 5/8" @ 151

drlg.

RECORD

Cased _____ in., _____ ft.

Sand _____

Gas _____

Oil _____

Total Depth _____

PRODUCTION

1st 24 hrs. Nat. _____

1st 24 hrs. after shot _____

Gas _____ Cu. Ft.

Dry Hole _____

Abandoned _____

Date

MAR 1 1950 19

J. E. TYRA

Scout

Kansas

Map No. _____ Sec. 12 Twp. 9 R. 22WWell No. 1 ThyfaultPickrell Drlg. Company

Contractor

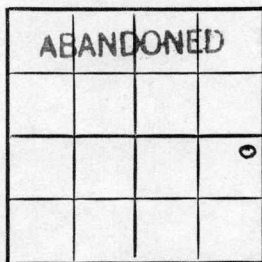
NE NE SE

E. 2270
SECTION PLAT330 Ft. from N. Line

_____ Ft. from S. Line

330 Ft. from E. Line

_____ Ft. from W. Line

Graham County

Location _____

Rig up _____

Drilling and Remarks:

8 5/8 @ 151
Jopeka 3248
Kub 3464
Dodge 3487
Lans 3502
arb 3843
D + A

RECORD

Cased _____ in., _____ ft.

Sand _____

Gas _____

Oil _____

Total Depth 3883

PRODUCTION

1st 24 hrs. Nat. _____

1st 24 hrs. after shot _____

Gas _____ Cu. Ft.

Dry Hole _____

Abandoned _____

Date

MAR 8 1950 19J. E. TYRA

Scout