


Section 12 Township 9 Range 23 W

Well No. #1 Mildrexter "A"

Company Transit Corp.

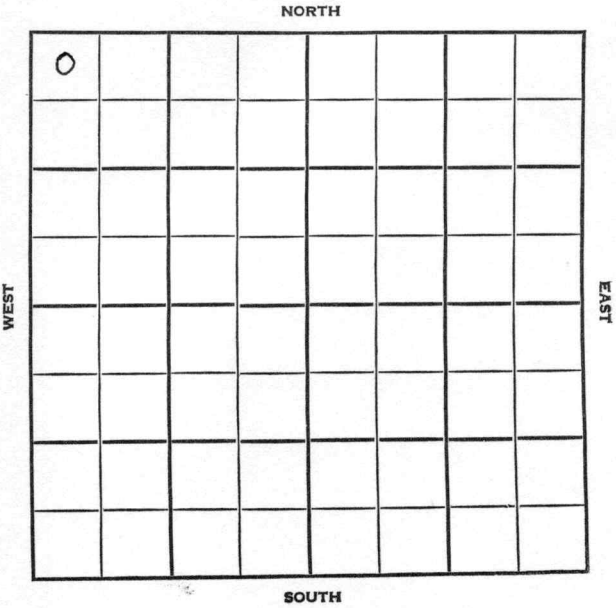

SEC.	TWP.	R.
12	9	23 W

WELL NO.

1 Mildrexter "A"

FARM

COMPANY

Transit Corp.

CONTRACTOR

Co. tools

Wildcat

Ft. from N. Line

Ft. from S. Line

Ft. from E. Line

Ft. from W. Line

NW NW NW

Stanolind- AcP^{OUTH} & DHM
Amerada - DHC

1/2 Mile - SDX Lse

ELEVATION

REPORT

1955

2354'

8/24

Comm. 8-18-55
8" @ 175 w/135
Dr1g. 3165'

9-1

Anhy 1950, Top. 3390, Heeb. 3616,
Tor. 3642., Lans. 3651,
DST 3715-40, open 1 hr., rec. 740'
vsocsw, 1040/20"
DST 3763-75, open 1 hr., rec. 30' so
spkd mud, 960#,
DST 3803-26, open 1 hr., rec. 90' vhocm
30' froggy oil, 60' clean oil, 1220/20"
DST 3825-42, open 1 hr., rec 240' sw,
985/20", 5½" @ 3890

9-8

CO 14/ 3814-16, B/.2 bo 9 gw 1 hr.,
500 A, S/ 25 bo 28 bw 5 hr., T & R

9-15

S/ 5 boph, 65% wtr.,
Putting on pump

9-22

Pmp 60 bo 73% wtr. 22 hrs;
Pmp 71 bo 33% wtr. 24 hrs.;

9-29

Pmp 45 bo plus 53% wtr. 24 hrs.

10-6

No report

10-13

11 12

10-20

11 11

OVER

1955

10/26 Comm 8-18-55
8" @ 175/135

Anh	1950	
Tp	3390	
H	3616	3618
Tr	3642	3639
L	3651	3651
BKC		3869
TD	3891	

DST 3715-40 open 1 hr Rec 740'
vsocsw 1040/20"

DST 3763-75 open 1 hr rec 30' so
spkd mud 960#

DST 3803-26 open 1 hr Rec 90' vhoem
30' a froggy oil 60' clean oil
1220/20"

DST 3825-42 open 1 hr rec 240' sw
985/20" 5 1/2" @ 3890

CO 14/3814-16 B/2 bo 9 gw 1 hr

500 A S/25 bo 28 bw 5 hr S/5

boph 65% wtr P/60 BO 73% wtr

22 hr P/71 bo 33% wtr 24 hr

P/45 bo 53% wtr 24 hr P/26 bopd
134 bw

Comp 31 BOPD 80% wtr.

COMPLETED

County Graham Elev. 2354
 Sec. 12 Twp. 9 Rge. 23W
 Company Transit Corp.
 Farm Name Mildrexter "A" No. 1

TOPS	DEPTH	LOG	DATUM	Loc. in Sec.
Anh.				NW NW NW
Tp.				
H.				
Tr.				
Dg.				
Bl.				
L.				Geol.
K.C.				Contr.
B.K.C.				Co. tools
Ce.				Pool
C.				Wildcat
M.				
M.				
K.				
Mz.				
Mq.				
V.				
S.				
S.				
A.				
R.				
Pe.				
G.				
T.D.				

AUG 24 '55		
FIRST REPORT		
1/2 mile		

Date Comm. 8-18-55

Stanolind AcP & DHM Amerada - DHC

8" @ 175/135 drlg. 3165



County Graham Elev. 2354Sec. 12 Twp. 9 Rge. 2 3WCompany Transit Corp.Farm Name Mildrexter "A" No. 1

TOPS	DEPTH	LOG	DATUM	Loc. in Sec.
Anh.	1950			NW NW NW
Tp.	3390		1036	
H.	3616	3618	1264	
Tr.	3642	3639	1285	
Dg.				
Bl.				
L.	3651	3651	1297	Geol.
K.C.				Contr.
B.K.C.		3869	1515	Co. tools
Ce.				Pool
C.				Wildcat
M.				
M.				
K.				
Mz.				
Mq.				
V.				
S.				
S.				
A.				
R.				
Pf.				
G.				
T.D.	3891			

Date Comm. 8-18-55 OCT 26 1955

8" @ 175/135 DST 3715-40 open 1 hr.

Rec. 740' vsocsw 1040/20" DST 3763-75

open 1 hr. rec. 30' so spkd mud 960#

DST 3803-26 open 1 hr. rec. 90' vhoem

30' froggy oil 60' clean oil 1220/20"

DST 3825-42 open 1 hr. rec. 240' sw

985/20" 5 1/2" @ 3890 CO 14/ 3814-16

B/ 2 bo 9 gw 1 h4. 500 A S/ 25 bo

OVER


28 bw 5 hr. S/ 5 boph 65% wtr.

P/ 60 bo 73% wtr. 22 hr.

P/ 71 bo 33% wtr. 24 hr. P/ 45 bo

53% wtr. 24 hr. P/ 26 bopd 134 bw

Comp. 31 bopd 80% wtr.

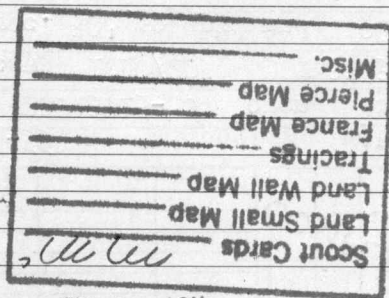

NOV 4 1955