

Graham


KANSAS

SECTION 12 TOWNSHIP 9 RANGE 24 W

WELL NO. #1 Hildebrand

COMPANY Harry Gore

NORTH

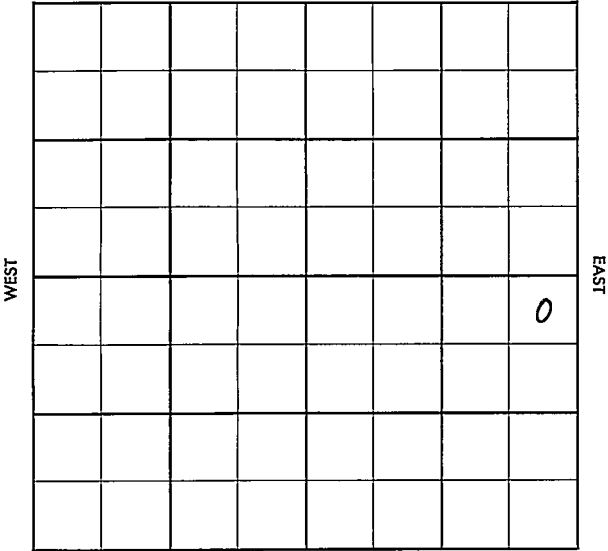

SOUTH

Graham

KANSAS

|      |      |      |
|------|------|------|
| SEC. | TWP. | R.   |
| 12   | 9    | 24 W |

WELL NO.

# 1 Hildebrand

FARM

COMPANY

Harry Gore.

CONTRACTOR


Empire  
Wildcat

\_\_\_\_\_ Ft. from N. Line

\_\_\_\_\_ Ft. from S. Line

\_\_\_\_\_ Ft. from E. Line

\_\_\_\_\_ Ft. from W. Line

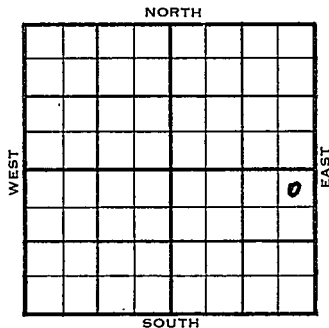

NE NE SE

SDX - 1 Mile Skelly - DHM Carter - FO

|      | ELEVATION | REPORT |
|------|-----------|--------|
| 1955 | 2418      |        |

11/23 Comm. 11-21-55  
8" @ 176/115  
WOC

12-1 Anhy 2082  
Heeb 3738  
Tor 3763  
Lans. 3778  
Drlg. 3946

12-7 D & A  
BKC 4006  
TD 4200'

ABANDONED

County Graham Elev. \_\_\_\_\_  
 Sec. 12 Twp. 9 Rge. 24W  
 Company Harry Gore  
 Farm Name Hildebrand No. 1

| TOPS   | DEPTH | LOG | DATUM | Loc. in Sec. |
|--------|-------|-----|-------|--------------|
| Anh.   |       |     |       | NE NE SE     |
| Tr.    |       |     |       |              |
| H.     |       |     |       |              |
| Tr.    |       |     |       |              |
| Dg.    |       |     |       |              |
| Bl.    |       |     |       |              |
| L.     |       |     |       |              |
| K.C.   |       |     |       | Geol. _____  |
| B.K.C. |       |     |       | Contr. _____ |
| Ce.    |       |     |       | Empire       |
| C.     |       |     |       |              |
| M.     |       |     |       | Pool         |
| M.     |       |     |       | Wildcat      |
| K.     |       |     |       |              |
| Mz.    |       |     |       |              |
| Mq.    |       |     |       |              |
| V.     |       |     |       |              |
| S.     |       |     |       |              |
| S.     |       |     |       |              |
| A.     |       |     |       |              |
| R.     |       |     |       |              |
| Pc.    |       |     |       |              |
| G.     |       |     |       |              |
| T.D.   |       |     |       |              |

1 mile  
 FIRST REPORT  
 NOV 23 1955

Date Comm. 11-21-55 Skelly DHM - Carter FO  
8" @ 176/115 WOC

*[Handwritten signature]*

County Graham Elev. 2418  
 Sec. 12 Twp. 9 Rge. 24W  
 Company Harry Gore  
 FarmName Haldebrand No. 1

| TOPS   | DEPTH       | LOG         | DATUM       |
|--------|-------------|-------------|-------------|
| Anh.   | <u>2082</u> |             |             |
| Tr.    |             |             |             |
| H.     | <u>3738</u> | <u>3740</u> | <u>1322</u> |
| Tr.    | <u>3763</u> | <u>3765</u> | <u>1347</u> |
| Dg.    |             |             |             |
| Bl.    |             |             |             |
| L.     | <u>3778</u> | <u>3783</u> | <u>1365</u> |
| K.C.   |             |             |             |
| B.K.C. | <u>4006</u> | <u>4006</u> | <u>1588</u> |
| Ce.    |             |             |             |
| C.     |             |             |             |
| M.     |             |             |             |
| M.     |             |             |             |
| K.     |             |             |             |
| Mz.    |             |             |             |
| Me.    |             |             |             |
| V.     |             |             |             |
| S.     |             |             |             |
| S.     |             |             |             |
| A.     |             |             |             |
| R.     |             |             |             |
| Pe.    |             |             |             |
| G.     |             |             |             |
| T.D.   | <u>4200</u> |             |             |

Loc. in Sec. NE NE SE

Geol. Empire

Contr. Wildcat

Pool Wildcat

|           |  |  |   |
|-----------|--|--|---|
| ABANDONED |  |  |   |
|           |  |  | 6 |

Date Comm. 11-21-55

DEC 7 1955

8" @ 176/115

D & A