


Section 13 Township 9 Range 16-W

Well No. 1 Dorr

Company Haynes et al

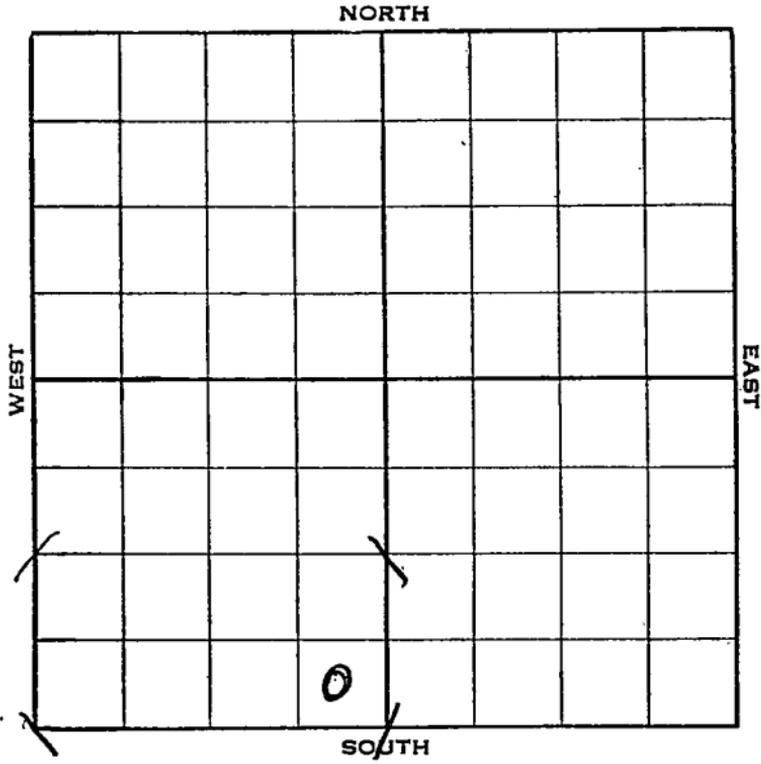

Sec. 13 Twp. 9 R. 16-W

Well No. #1 Door Farm \_\_\_\_\_  
Haynes et al Company \_\_\_\_\_


\_\_\_\_\_ Ft. from N. Line

330 Ft. from S. Line

330 Ft. from E. Line

\_\_\_\_\_ Ft. from W. Line

Elev. 2067

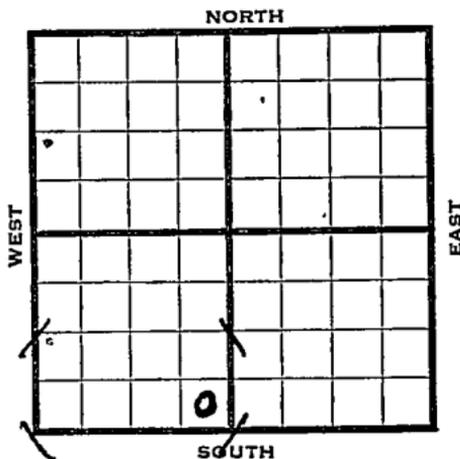

1938	REPORT
6/8	RUCT.
6/17	" "
6/24	Drlg. 585'.
7/1	15" - 676' Drlg. 975'.
7/8	Anhy 1290'. 10" - 1299'. Drlg. 1825'.
7/15	Fighting cave 2400'.
7/22	8" - 2670'. T.D. 2765'. U. R.
7/29	8" - 2777'. Dlg. 2845'.
8/5	6" - 2690'. sd. 3225'.
8/12	Lans. 3247'. T.D. 3257'. S. O. Rng. 5".
8/19	1 bailer oil per hr. 3355-57'. 5" - 3357'. Dlg. 3400'.
8/26	5" - 3436'. T.D. 3515'. C. O.
9/2	U. R. 5" - 3440'.
9/9	5" - 3465'. Dlg. 3573'.
9/16	Granite 3610'. T. D. 3613'. Will P. B. to Lans.

OVER

1938

9/23 T.D. 3613'.--  
Will P. B. to lans.

9/30 T. D. 3614'. P. B. 3350'.  
5" - 3336'. 1000 acid.  
Swb. 2 oil & 4 wtr. per hr. 17  
hrs. Will reacidize. .

10/5 5" - 3336'.  
Lans. 3247'. . . . .  
Cherty Cong. 3599'.  
T. D. 3614'.  
P. B. to 3350'. -  
1000 acid. .  
15 bbls. oil.

COMPLETED

Map No. 64 Sec. 13 Twp. 9 R. 16WWell No. 1 DorrHaynes etal


Company

Contractor

## FIRST REPORT

## SECTION PLAT

**SE SW**  
 \_\_\_\_\_ Ft. from N. Line  
330 Ft. from S. Line  
330 Ft. from E. Line  
 \_\_\_\_\_ Ft. from W. Line

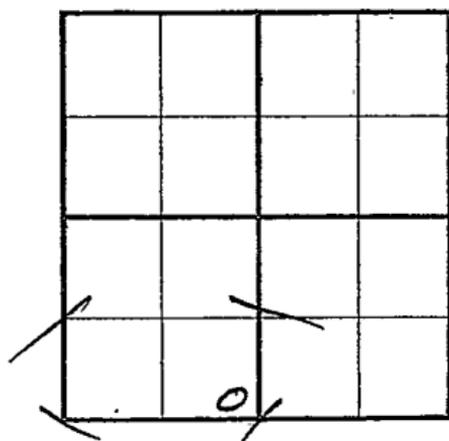

Location \_\_\_\_\_

Rig up \_\_\_\_\_

Drilling and Remarks:

**RUCT**

## RECORD

Cased \_\_\_\_\_ in., \_\_\_\_\_ ft.

Sand \_\_\_\_\_

Gas \_\_\_\_\_

Oil \_\_\_\_\_

Total Depth \_\_\_\_\_

## PRODUCTION

1st 24 hrs. Nat. \_\_\_\_\_

1st 24 hrs. after shot \_\_\_\_\_

Gas \_\_\_\_\_ Cu. Ft.

Dry Hole \_\_\_\_\_

Abandoned \_\_\_\_\_

Date

JUN 8 - 1938 19H. D. Hatfield Scout

Map No. 64 Sec. 13 Twp. 9 R. 16 WWell No. 1 DorrHaynes etal

Company

Contractor

**COMPLETED****SECTION PLAT**

SE SW

\_\_\_\_\_ Ft. from N. Line

330 Ft. from S. Line330 Ft. from E. Line

\_\_\_\_\_ Ft. from W. Line


Location \_\_\_\_\_

Rig up \_\_\_\_\_

Drilling and Remarks:

P.B. 33501000 Acid15 bbls**RECORD**Cased 5 in., 3336 ft.Sand LANS 3247Gas Cherly Cong 3599

Oil \_\_\_\_\_

Total Depth 3614**PRODUCTION**

1st 24 hrs. Nat. \_\_\_\_\_

1st 24 hrs. after shot \_\_\_\_\_

Gas \_\_\_\_\_ Cu. Ft.

Dry Hole \_\_\_\_\_

Abandoned \_\_\_\_\_

Date

OCT 5 - 1938 19H. D. Hatfield

Scout