


KANSAS

Section 13 Township 9 Range 16W

Well No. #2 Dorr

Company G.C. Battin et al

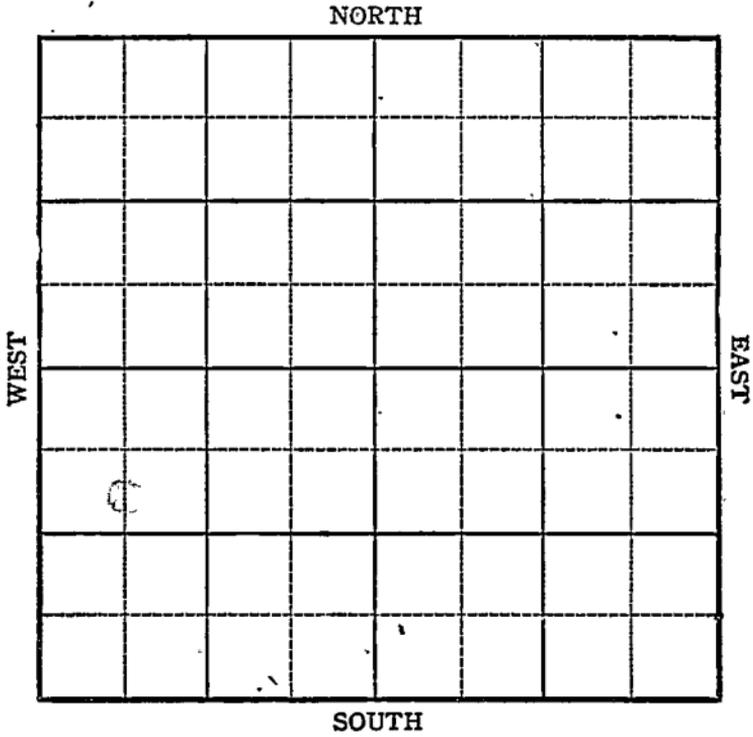

Sec. 13 Twp. 9S R. 16W

Well No. #2, Dobr Farm

G.C. Battin et al Company


Laton

990 Ft. from N. Line

_____ Ft. from S. Line

_____ Ft. from E. Line

990 Ft. from W. Line

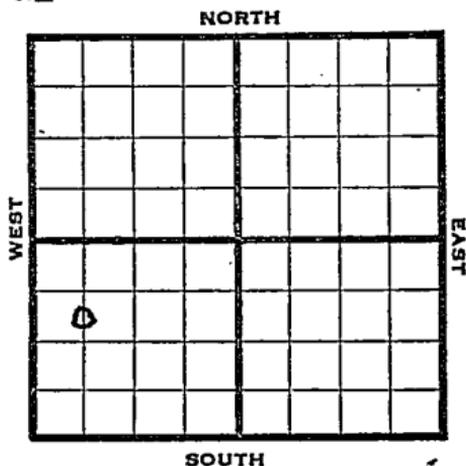

C S L NW SW

1945

R E P O R T

1-10 10" @ 98'
 Anhydrite 1320
 Topeka 2960
 Lansing 3240
 Show Oil 3267-71
 Total Depth 3321'
 6" @ 3321'
 Rigging up standard tools.
 1/26 Fsg. bailer
 1/31 Fishing bailer
 2/5 " "
 2/14 Drlg 3325
 2/21 TD 3335
 1600 oil in 12 hrs 500 acid
 pump 20 oil PH 8 hrs SW
 2/28 " " " " " "
 3/7 TD 3335 - 200 oil PH 8 hrs SW
 3/14 " " " " " "
 3/23 " " " " " "
 3/28 Lans 3240
 6" @ 3321'
 5000 acid.
 TD 3335'
 Pump 8 Pot.
 Grav. 27.4

COMPLETED

Pool Name Laton

Map No. 64 Sec. 13 Twp. 9 R. 16W

Well No. 2 Dorr

G.C. Battin et al Company

FIRST REPORT Contractor

C S L NW SW

SECTION PLAT

990 Ft. from N. Line

_____ Ft. from S. Line

_____ Ft. from E. Line

660 Ft. from W. Line

Rocks

Location _____

Rig up _____

Drilling and Remarks:
10"-98'

enhy 1320

Topeka 2960

lens 3240

SO 3267-71

3321 TD

6"-3321 rust

RECORD

Cased _____ in., _____ ft.

Sand _____

Gas _____

Oil _____

Total Depth _____

PRODUCTION

1st 24 hrs. Nat. _____

1st 24 hrs. after shot _____

Gas _____ Cu. Ft.

Dry Hole _____

Abandoned _____

Date

JAN 10 1945 19

S. J. LEWIS Scout

Pool Name Leton

Map No. 104 Sec. 13 Twp. 9 R. 16W

Well No. 2 Dorr

G. C. Battin et al Company

COMPLETED Contractor

C S L ¹¹W SW

SECTION PLAT

990 Ft. from N. Line

_____ Ft. from S. Line

_____ Ft. from E. Line

660 Ft. from W. Line

Rocks

Location _____

Rig up _____

Drilling and Remarks:

Louis 3240
6" @ 3321
5000 acid
Pump & Prod

27 1/2 cu

RECORD

Cased _____ in., _____ ft.

Sand _____

Gas _____

Oil _____

Total Depth 3325

PRODUCTION

1st 24 hrs. Nat. _____

1st 24 hrs. after shot _____

Gas _____ Cu. Ft.

Dry Hole _____

Abandoned _____

Date

MAR 28 1945

S. J. LEWIS Scout