


Section 13 Township 9 Range 16-W

Well No. #3 Dorr

Company B. C. Battin

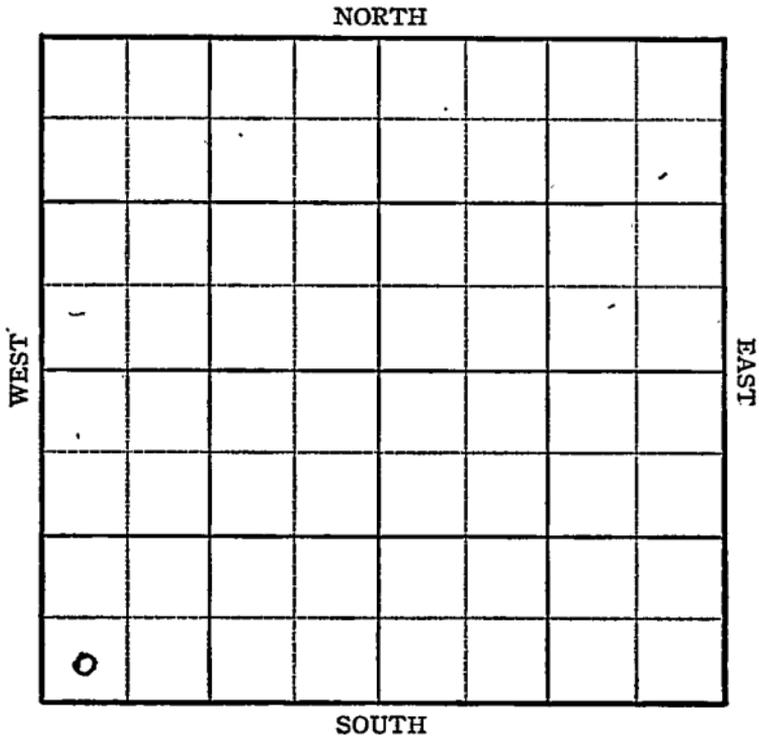

KANSAS

Sec. 13 Twp. 9 R. 16W

Well No. #3 Dorr Farm

B. C. Battin Company

Laton


_____ Ft. from N. Line

330 Ft. from S. Line

_____ Ft. from E. Line

330 Ft. from W. Line

SW/c

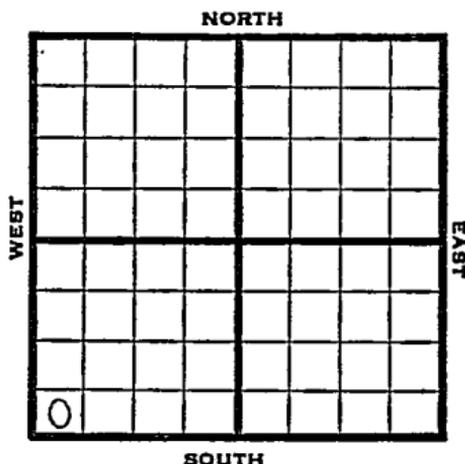

1946

Elev. 2081

REPORT

2/20

8" @ 100
 Anhy. 1328
 Lans 3248
 SO 3317-3324
 TD 3469'
 5" @ 3463'
 24 shots 3317-3324 CO

2/27

Lans. 3248
 5" @ 3463
 Perf. Lans.
 7000 acid.
 TD 3469
 Pump 25 Pot.
 Grav. 38.0

COMPLETED

Kansas Pool Name Laton
 KANSAS
 Map No. 64 Sec. 13 Twp. 9 R. 16W
 Well No. 3 Dorr

B. C. Battin Company

FIRST REPORT

Contractor

SW/c

SECTION FLAT

_____ Ft. from N. Line

330 Ft. from S. Line

_____ Ft. from E. Line

330 Ft. from W. Line

Rooks County

Location _____

Rig up _____

Drilling and Remarks:

8ⁿ-100

Anhy 1328

Lans 3248

SO 3317-24

TD 3469

5ⁿ-3463

24 shots 3317-

24 CO

RECORD

Cased _____ in., _____ ft.

Sand _____

Gas _____

Oil _____

Total Depth _____

PRODUCTION

1st 24 hrs. Nat. _____

1st 24 hrs. after shot _____

Gas _____ Cu. Ft.

Dry Hole _____

Abandoned _____

Date

FEB 20 1946 19

S. J. LEWIS Scout

Kansas Pool Name Laton

Map No. 64 Sec. 13 Twp. 9 R. 16W

Well No. 3 Dorr

B. C. Battin Company

COMPLETED

Contractor

SW/c

E 12087
SECTION PLAT

0			

 Ft. from N. Line

330 Ft. from S. Line

 Ft. from E. Line

330 Ft. from W. Line

Rooks County

Location

Rig up

Drilling and Remarks:


RECORD

Cased in., ft.

Sand

Gas

Oil

Total Depth 3469

PRODUCTION

1st 24 hrs. Nat.

1st 24 hrs. after shot

Gas Cu. Ft.

Dry Hole

Abandoned

Date

FEB 27 1946

19

S. I. LEWIS

Scout