

Well No. # 5 Doer

Company Battin & Wheeler


Rooks

KANSAS

SEC.

13

TWP.

9

R.

16W

WELL NO.

#5 Doer

FARM

COMPANY

Battin & Wheeler

CONTRACTOR

Veeder

Ft. from N. Line

330


Ft. from S. Line

860

Ft. from E. Line

Ft. from W. Line

C S L SE SW

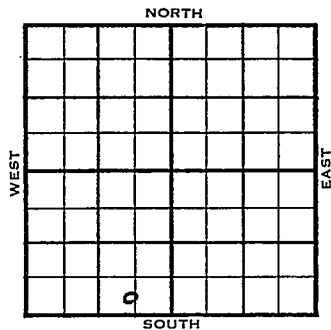

1953

ELEVATION

2068'

REPORT

10/14

Spud 10-5-53

8" @ 122'

Circ @ 3028

10/21

Spud 10-5-53

D&A

TD 3535

8" @ 122'

Top 2973, Heeb 3199', Tor 3219',

Lans 3241'

DST 3343-53, opn 1 hr., rec. 180'

sul. wtr. 330#

DST 3404-27, opn 3/4 hrs., rec. 32'

mud, 710#


B KC 3506

TD 3535

D&A

ABANDONED


County Rooks State Kansas
 Sec. 13 (Blk.) 9 (Sur.) 16W Map No.
 Operator Battin & Wheeler
 Well No. 5 Farm Doer
 Elev. Location C S L SE SW

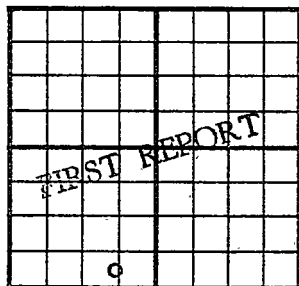

330 Ft. From S Line SW
860 Ft. From E Line Quarter
 1st. Report OCT 14 1953
 Completion
 Remarks
Veeder - Contr.
 Spudding Date 10-5-53


Drlg. Data

8" @ 122 circ. @ 3028

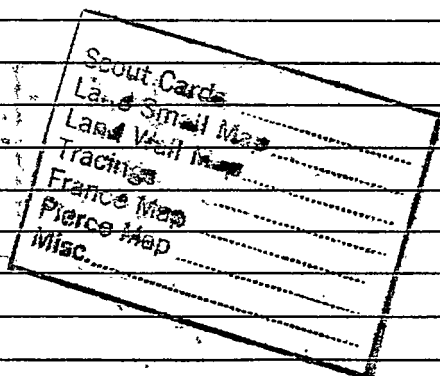

J. G. McGEHEE

County _____ Rooks _____ State Kansas
 Sec. 13 (Blk.) 9 (Sur.) 16W Map No. _____
 Operator Battin & Wheeler
 Well No. 5 Farm Doer
 Elev. 2068 Location C S L SE SW

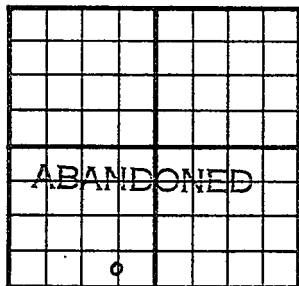

330 Ft. From S Line SW
860 Ft. From E Line Quarter

1st. Report

Completion OCT 21 1953

Remarks

Veeder - Contr.

Spudding Date 10-5-53

Drilg. Data D & A TD 3535

8" @ 122 Top. 2973 Heeb. 3199

Tor. 3219 Lans. 3241 DST 3343-53

open 1 hr. Rec. 180' sul. wtr. 330#

DST 3404-27 open 3/4 hr. Rec. 32' mud

710# B KC 3506 TD 3535

D & A

J. G. McGEHEE