


Section 13 Township 9 Range 17W

Well No. #2 Dougherty

Company C. W. Trickett et al

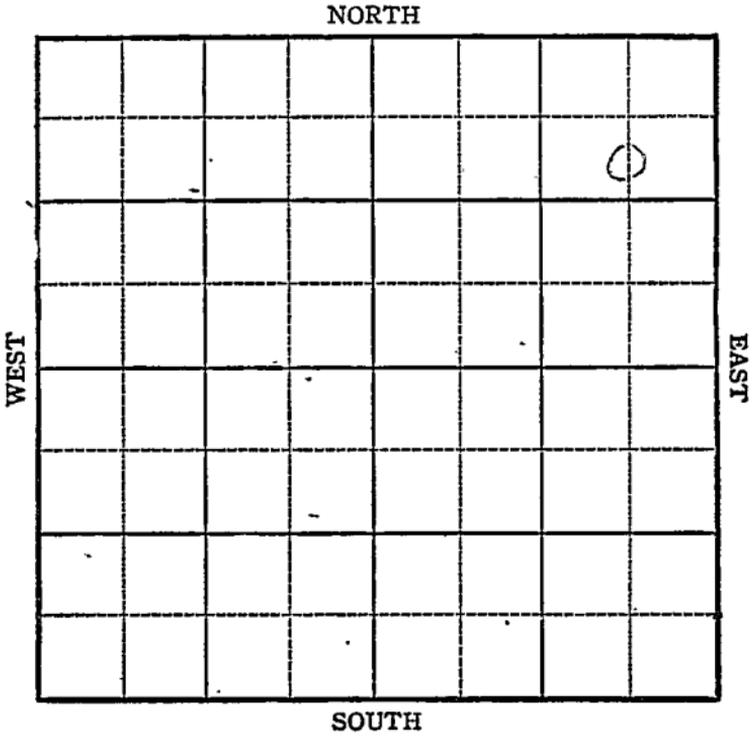

KANSAS

Rooks County


Sec. 13 Twp. 9 R. 17W

Well No. #2 Dougherty Farm

C. W. Trickett et al Company

Westhusin

NORTH

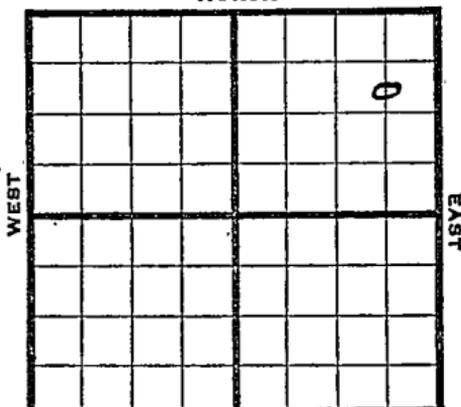

990 Ft. from N. Line

\_\_\_\_\_ Ft. from S. Line

660 Ft. from E. Line

\_\_\_\_\_ Ft. from W. Line

CSL NE NE Elev. 2025 SOUTH

1944

REPORT

11/1 8" @ 20'  
Drlg. 2370'

11/8 Lans 3149  
TD 3159 Run. csg.

11/16 Lans 3154 corrected  
TD 3174  
5" stuck at 2450

11/24 5" @ 3174 RUST

11/29 " " " "

12/6 " " " "

12/14 " " " "

12/21 TD 3195  
2000 acis

12/29 1500 oil in 2 hrs.

1945

1/3 " " " " "

1/10 " " " " "

1/17 Lans 3154  
5" @ 3174 T.D. 3195'  
2000 acid  
Pump 50 Pot  
Grav. 37.0

COMPLETED

Pool Name WesthusinMap No. 64 Sec. 13 Twp. 9 R. 17WWell No. 2 DoughertyC. W. Trickett <sup>INC</sup> tal CompanyFIRST REPORT ContractorC S L N E N E

## SECTION PLAT


990 Ft. from N. Line         Ft. from S. Line660 Ft. from E. Line         Ft. from W. Line

Rooks County

Location                                 Rig up                                 

Drilling and Remarks:

8" - 20'2370

## RECORD

Cased                  in.,                  ft.Sand                                 Gas                                 Oil                                 Total Depth                                 

## PRODUCTION

1st 24 hrs. Nat.                                 1st 24 hrs. after shot                                 Gas                                  Cu. Ft.Dry Hole                                 Abandoned                                 

Date

NOV 1 1944 19S. J. LEWIS Scout

KANSAS

Pool Name WesthusinMap No. \_\_\_\_\_ Sec. 13 Twp. 9 R. 17WWell No. 2 DoughertyC. W. Trickett et al Company

COMPLETED

Contractor

C S L NE NE

## SECTION FLAT

990 Ft. from N. Line

\_\_\_\_\_ Ft. from S. Line

660 Ft. from E. Line

\_\_\_\_\_ Ft. from W. Line

			o

Rooks County

Location \_\_\_\_\_

Rig up \_\_\_\_\_

Drilling and Remarks:

*Lane 3154**5" @ 3174**2000 @ well**Run 50 Pct.**37 @*

## RECORD

Cased \_\_\_\_\_ in., \_\_\_\_\_ ft.

Sand \_\_\_\_\_

Gas \_\_\_\_\_

Oil \_\_\_\_\_

Total Depth 2175

## PRODUCTION

1st 24 hrs. Nat. \_\_\_\_\_

1st 24 hrs. after shot \_\_\_\_\_

Gas \_\_\_\_\_ Cu. Ft.

Dry Hole \_\_\_\_\_

Abandoned \_\_\_\_\_

Date

JAN 17 1915

19

S. J. LEWIS Scout