


KANSAS

Rocks County

Section 13 Township 9 Range 17-WWell No. #5 DoughertyCompany G W TrickettWesthusin Pool

NORTH

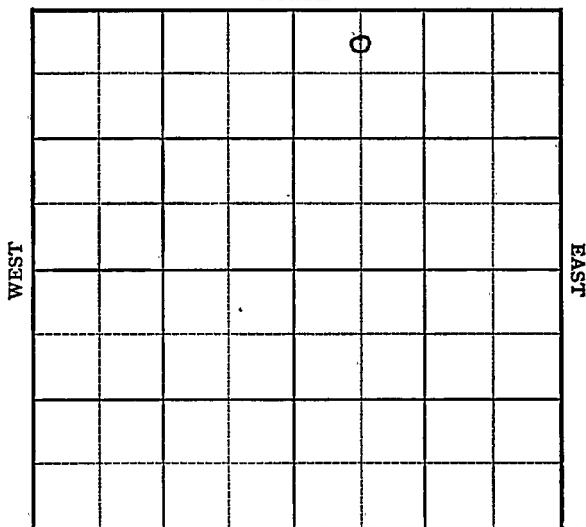

SOUTH

KANSAS

Rooks

Sec. 13 Twp. 9 R. 17W ✓

Well No. 5 Dougherty Farm

C.W. Trickett

Company

Westhusin

Sterling Drlg. Contr.


330 Ft. from N. Line

 Ft. from S. Line

 Ft. from E. Line

660 Ft. from W. Line

C N L NW NE

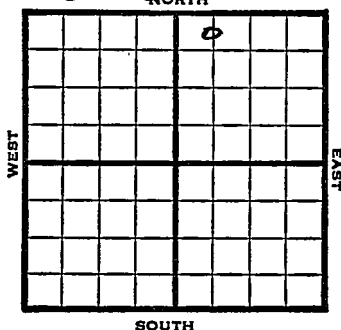

1949

Elev. 2024' REPORT

8/24

8" @ 1000

Anhy 1700

Drlg. 2030

8/31

Lansing 3158'

Arbuckle 3453'

TD 3457'

5" @ 3454'

9/7

325 acid 2400' oil 12 hrs.

9/14

"

9/21

"

9/28

"

10/5

"

10/12

"

10/19

"

10/26

Arb 3453'

5" @ 3454'

325 acid

Pump 30 oil & 35% W Pot.

Gr. 27°

TD 3457'

COMPLETED

Map No. _____ Sec. 13 Twp. 9 R. 17W

Well No. 5 Dougherty

C. W. Trickett Company

Sterling Drlg. Contractor

C N L NW NE

FIRST REPORT

SECTION PLAT

		o	

330 Ft. from N. Line

Ft. from S. Line

Ft. from E. Line

660 Ft. from W. Line

Rooks County

Location _____

Rig up _____

Drilling and Remarks:

8" @ 1000

Anhy 1700

drlg. 2030

RECORD

Cased _____ in., _____ ft.

Sand _____

Gas _____

Oil _____

Total Depth _____

PRODUCTION

1st 24 hrs. Nat. _____

1st 24 hrs. after shot _____

Gas _____ Cu. Ft.

Dry Hole _____

Abandoned _____

Date

AUG 24 1949 19

S. J. LEWIS

Scout

Kansas

Westhusin Pool

Map No. _____ Sec. 13 Twp. 9 R. 17WWell No. 5 DoughertyC. W. Trickett

Company _____

COMPLETE

Contractor _____

C N L NW NE

E1.2024
SECTION PLAT330

Ft. from N. Line

Ft. from S. Line

Ft. from E. Line

660

Ft. from W. Line

		o	

Rooks County

Location _____

Rig up _____

Drilling and Remarks:

Cr X 34535" C 345435 C 3456Prod 30 oil + 35 gasProd27.5 cu

RECORD

Cased _____ in., _____ ft.

Sand _____

Gas _____

Oil _____

Total Depth 34.57

PRODUCTION

1st 24 hrs. Nat. _____

1st 24 hrs. after shot _____

Gas _____ Cu. Ft.

Dry Hole _____

Abandoned _____

Date

OCT 26 1949

19

S. J. LEWIS

Scout