


Section 13 Township 9 Range 17-W

Well No. #6 Mary Dougherty

Company C W Trickett

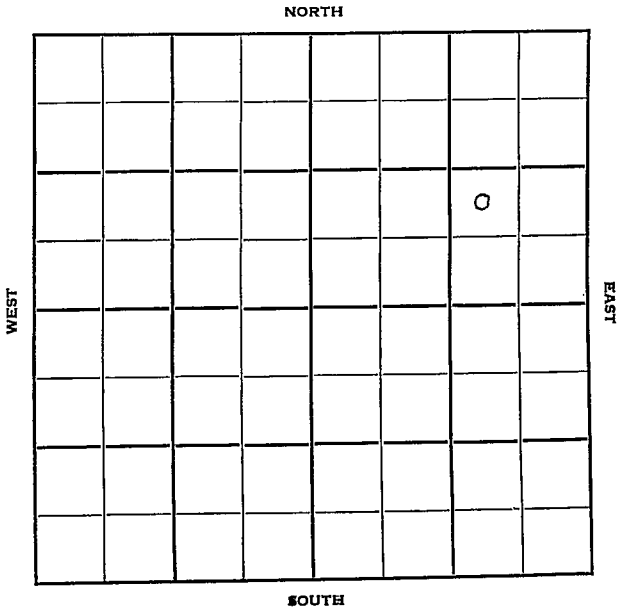

Sec. 13 Twp. 9 R. 17W

Well No. #6 Mary Dougherty Farm

G. W. Trickett Company

Sterling Drlg. Contractor

Westhusin


\_\_\_\_\_ Ft. from N. Line

990' Ft. from S. Line

990' Ft. from E. Line

\_\_\_\_\_ Ft. from W. Line

NW SE NE

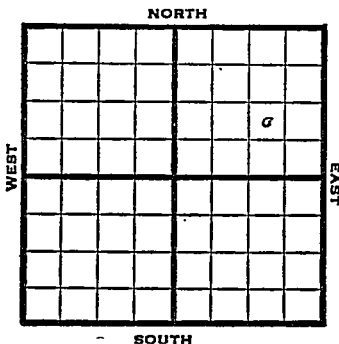

1950

Elev. 2030' REPORT

7/19

Spud 7-11-50

8" @ 80'

Anhy 1280'

Drlg. 3047'

10/18

Spud 7-11-50

Oil Well TD 3469'

8" @ 80' Anhy 1280'

Top 2906' Heeb 3123'

Dodge 3143' Lans. 3161'

Arb. 3454-57

5" @ 3455' : TD 3457½

Test 10 GOPH 350 A DD 3469'

40 BOPD

**COMPLETED**

Kansas

Map No. \_\_\_\_\_ Sec. 13 Twp. 9 R. 17WWell No. 6 Mary DoughertyC. W. Trickett CompanySterling Drlg. Contractor

NW SE NE

## SECTION PLAT

			0

FIRST REPORT

\_\_\_\_\_ Ft. from N. Line

990 Ft. from S. Line990 Ft. from E. Line

\_\_\_\_\_ Ft. from W. Line

Rooks County

Location \_\_\_\_\_

Rig up \_\_\_\_\_

Drilling and Remarks:

Spud 7-11-50

8" @ 80

Anhy 1280

drlg. 3047

## RECORD

Cased \_\_\_\_\_ in., \_\_\_\_\_ ft.

Sand \_\_\_\_\_

Gas \_\_\_\_\_

Oil \_\_\_\_\_

Total Depth \_\_\_\_\_

## PRODUCTION

1st 24 hrs. Nat. \_\_\_\_\_

1st 24 hrs. after shot \_\_\_\_\_

Gas \_\_\_\_\_ Cu. Ft.

Dry Hole \_\_\_\_\_

Abandoned \_\_\_\_\_

Date

JUL 19 1950J. E. TYRA Scout

