


KANSAS

Rooks

Section 13 Township 9 Range 17WWell No. 1 SmithCompany Delta & Harbar

Westhusin Pool

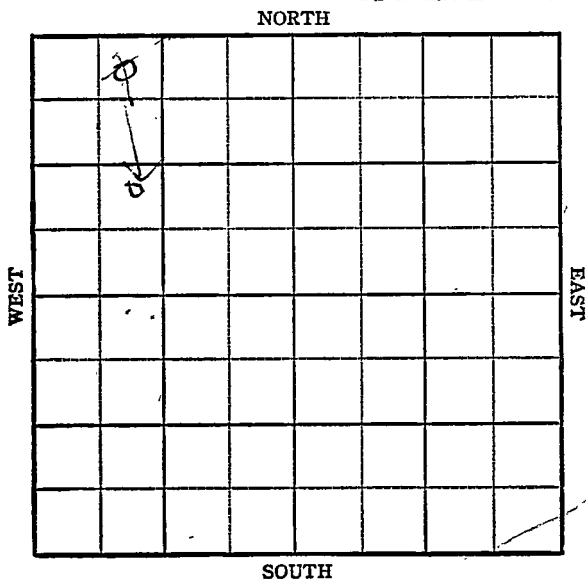

Sec. 13 Twp. 9 R. 17-W ✓

Well No. #1 Smith Farm


Delta & Harbar Company

Westhusin
330 Ft. from N. Line

990 Ft. from S. Line

 Ft. from E. Line

990 Ft. from W. Line

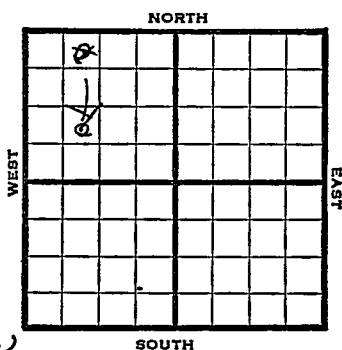

~~NE NW NW~~ NE SW NW

1948	Eli 2064'	REPORT
9/29	Location	
10/6	"	
10/13	"	
10/19	"	
10/26	"	
11/3	"	
11/10	"	
11/16	"	
11/23	"	
11/30	"	
12/8	Surface hole	
12/15	10" @ 311'	
	D rlg 3200'	
12/22	SD	
12/29	TD 352 8'	
	Labs. 3189'	
	Arb. 3468'	
	Aband.	
	ABANDONED	

Map No. _____ Sec. 13 Twp. 9 R. 17WWell No. 1 Smith


_____ Delta & Harbar _____ Company

FIRST REPORT

_____ Contractor

NE NW NW

SECTION PLAT

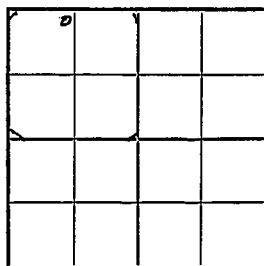330 Ft. from N. Line

_____ Ft. from S. Line

_____ Ft. from E. Line

990 Ft. from W. Line

Rooks County

Location X

Rig up _____

Drilling and Remarks:

RECORD

Cased _____ in., _____ ft.

Sand _____

Gas _____

Oil _____

Total Depth _____

PRODUCTION

1st 24 hrs. Nat. _____

1st 24 hrs. after shot _____

Gas _____ Cu. Ft.

Dry Hole _____

Abandoned _____

Date

SEP 29 1948 19 _____ S. J. LEWIS Scout

Map No. 64 Sec. 13 Twp. 9 R. 17W

Well No. 1 Smith

Delta Prod. Company

CORRECTION

Contractor

NE SW NW

SECTION PLAT

 Ft. from N. Line

990 Ft. from S. Line

 Ft. from E. Line

990 Ft. from W. Line

o			

Rooks County

Location

Rig up

Drilling and Remarks:

Reported

NE NW NW - 2

RECORD

Cased in., ft.

Sand

Gas

Oil

Total Depth

PRODUCTION

1st 24 hrs. Nat.

1st 24 hrs. after shot

Gas Cu. Ft.

Dry Hole

Abandoned

Date

DEC 15 1948 19

S. J. LEWIS Scout

Map No. 64 Sec. 13 Twp. 9 R. 17WWell No. 1 SmithDelta & Harbar

Company

ABANDONED

Contractor

NE SW NW

E12064
SECTION PLAT Ft. from N. Line990 Ft. from S. Line Ft. from E. Line990 Ft. from W. Line

o			

Rooks County

Location Rig up

Drilling and Remarks:

Loss 3179As 3468

RECORD

Cased in., ft.Sand Gas Oil Total Depth 3525

PRODUCTION

1st 24 hrs. Nat. 1st 24 hrs. after shot Gas Cu. Ft.Dry Hole Abandoned

Date

DEC 29 1948 19

S. J. LEWIS Scout