



Sec. 13 Twp. 9 R. 17-W

Well No. #1 Smith Farm

Schermerhorn Company

(Westhusin)


660 Ft. from N. Line

\_\_\_\_\_ Ft. from S. Line

330 Ft. from E. Line

\_\_\_\_\_ Ft. from W. Line

Elev. 2041

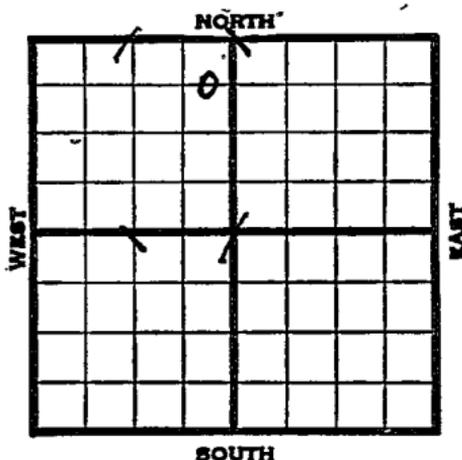

1939	REPORT.
12/20	Location
12/28	"
1940	
1/4	Drlg. 1100'
1/11	10" - 150'
	Drlg. 1980'
1/18	Fsg. 2441'
1/25	Drlg. 2765'
2/1	Lans. 3168' SSO 3211-15 & SSO 3285-98' Drlg. 3300'
2/8	Arb. 3457' T.D. 3459' 6" - 3459' RUST.
2/15	T.D. 3470' S.S. heavy black oil. Shut down.
2/23	" "
2/29	" "
3/8	" "
3/14	" "
3/21	900 aci d. No increase. 66 shots 3209-35' 1000 acid. Testing.
	<b>OVER</b>

1940  
3/27

Arb. 3457'

6" - 3459'

T.D. 3470'

P.B.

66 shots 3209-35'

5000 acid.

15 bbls. oil.

COMPLETED

Map No. 64 Sec. 13 Twp. 9 R. 17WWell No. 1 SmithSchermerhorn

Company

Contractor

## FIRST REPORT

C E L NE NW

660 Ft. from N. Line

\_\_\_\_\_ Ft. from S. Line

330 Ft. from E. Line

\_\_\_\_\_ Ft. from W. Line

WESTHUSIN POOL

## SECTION PLAT


Location X

Rig up \_\_\_\_\_

Drilling and Remarks:

## RECORD

Cased \_\_\_\_\_ in., \_\_\_\_\_ ft.

Sand \_\_\_\_\_

Gas \_\_\_\_\_

Oil \_\_\_\_\_

Total Depth \_\_\_\_\_

## PRODUCTION

1st 24 hrs. Nat. \_\_\_\_\_

1st 24 hrs. after shot \_\_\_\_\_

Gas \_\_\_\_\_ Cu. Ft.

Dry Hole \_\_\_\_\_

Abandoned \_\_\_\_\_

Date

DEC. 20 1939 19

S. J. LEWIS Scout

Map No. 64 Sec. 13 Twp. 9 R. 17W

Well No. 1 Smith

Schermerhorn

Company

Contractor

**COMPLETED**

**SECTION PLAT**

660 **C E L N E** NW  
Ft. from N. Line

\_\_\_\_\_ Ft. from S. Line

330 Ft. from E. Line

\_\_\_\_\_ Ft. from W. Line


**WESTHUSIN POOL**

Location \_\_\_\_\_

Rig up \_\_\_\_\_

Drilling and Remarks:

*cu 8 3452*  
*L " 03459*  
*P.B.*  
*66 Barts 0209-35*  
*5000 acid*  
*15 1/2 hrs.*

**RECORD**

Cased \_\_\_\_\_ in., \_\_\_\_\_ ft.

Sand \_\_\_\_\_

Gas \_\_\_\_\_

Oil \_\_\_\_\_

Total Depth 3470

**PRODUCTION**

1st 24 hrs. Nat. \_\_\_\_\_

1st 24 hrs. after shot \_\_\_\_\_

Gas \_\_\_\_\_ Cu. Ft.

Dry Hole \_\_\_\_\_

Abandoned \_\_\_\_\_

Date

MAR 27 1940 19

S. J. LEWIS Scout