

KANSAS

Rooks

Section 13 Township 9 Range 17W

Well No. 1 Westhusin


Company Stearns Pet.

Westhusin

NORTH

WEST

EAST

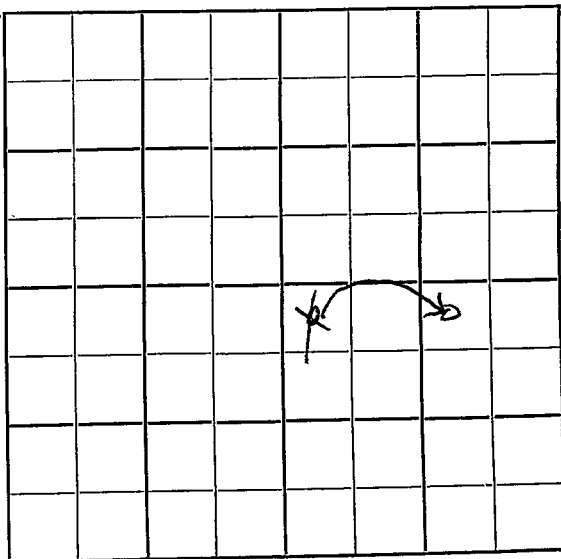

SOUTH

Rooks

KANSAS

✓ 17W

Sec. 13 Twp. 9 R. 17W

Well No. #1 Westhusin Farm

Stearns-Pet.

Company

Westhusin (Stearns, Cont.)

Pool

330'

Ft. from N. Line

Ft. from S. Line

990


Ft. from E. Line

330'

Ft. from W. Line

~~NW SE~~

nw ne 88

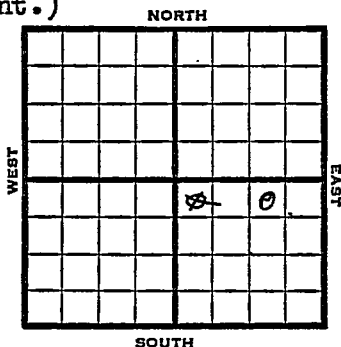

1949

Elev. 2080' REPORT

7/6

8" @ 225'

Anhy. 1263'

Drlg. 1430' -

7/12

Lansing 3146'

Drlg 3190'

7/20

Abandoned

Arb. 3441'

TD 3446'

ABANDONED

Map No. _____ Sec. 13 Twp. 9 R. 17W

Well No. 1 Westhusin

Stearns Pet. _____ Company

Stearns _____ Contractor

NW SE

**FIRST REPORT
SECTION PLAT**

330 Ft. from N. Line

_____ Ft. from S. Line

_____ Ft. from E. Line

330 Ft. from W. Line

		o	

Rooks County

Location _____

Rig up _____

Drilling and Remarks:

8" @ 225

Anhy 1263

drlg. 1430

RECORD

Cased _____ in., _____ ft.

Sand _____

Gas _____

Oil _____

Total Depth _____

PRODUCTION

1st 24 hrs. Nat. _____

1st 24 hrs. after shot _____

Gas _____ Cu. Ft.

Dry Hole _____

Abandoned _____

Date

JUL 6 1949

19

S. J. LEWIS

Scout

Kansas

Westhusin Pool

Map No. 1164 Sec. 13 Twp. 9 R. 17WWell No. 1 Westhusin

Stearns Drlg. _____ Company

CORRECTION

Contractor _____

NW NE SE

SECTION PLAT

			o

330 Ft. from N. Line

_____ Ft. from S. Line

990 Ft. from E. Line

_____ Ft. from W. Line

Rooks County

Location _____

Rig up _____

Drilling and Remarks:

Reported

NW SE

RECORD

Cased _____ in., _____ ft.

Sand _____

Gas _____

Oil _____

Total Depth _____

PRODUCTION

1st 24 hrs. Nat. _____

1st 24 hrs. after shot _____

Gas _____ Cu. Ft.

Dry Hole _____

Abandoned _____

Date

JUL 13 1949

19

S. J. LEWIS

Scout

Kansas

Westhusin Pool

Map No. K64 Sec. 13 Twp. 9 R. 17WWell No. 1 Westhusin

Stearns Pet.

Company

ABANDONED

Contractor

NW NE SE

E 1,2080
SECTION PLAT330 Ft. from N. Line Ft. from S. Line990 Ft. from E. Line800 Ft. from W. Line

			0

Rooks

Location

Rig up

Drilling and Remarks:

Cut 3441

RECORD

Cased in. ft.Sand Gas Oil Total Depth 3446

PRODUCTION

1st 24 hrs. Nat. 1st 24 hrs. after shot Gas Cu. Ft.Dry Hole Abandoned

Date

JUL 20 1949 19S. J. LEWIS Scout