

Section 13 Township 9 Range 18-W

Well No. #1 Daisy Burton

Company Continental  
Wildcat

[illegible]

Rooks

KANSAS

Sec. 13 Twp. 9 R. 18W

Well No. #1 Daisy Burton Farm

Continental

Company

Contractor

Wildcat

Ft. from N. Line

330'

Ft. from S. Line


Ft. from E. Line

330'

Ft. from W. Line

SW SW SE

Core drill

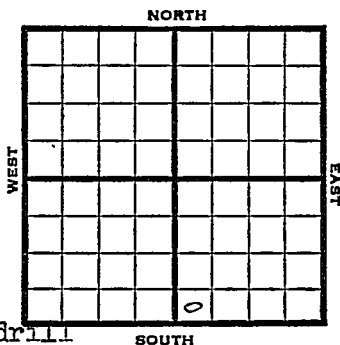

SOUTH

1950

Elev 2074'

REPORT

3/1

Spud 2-23-50

10" @ 204'

Anhy 1445'

Drlg. 2161'

TD 3667'

10" @ 204'

Lans 3289'

Cong 3547'

Arb. 3618'

D&A

Aband.

3/15

**ABANDONED**

Map No. \_\_\_\_\_ Sec. 13 Twp. 9 R. 18WWell No. 1 Daisy Eurtan

\_\_\_\_\_ Continental \_\_\_\_\_

Company

\_\_\_\_\_ Contractor

SW SW SE

## SECTION PLAT

\_\_\_\_\_ Ft. from N. Line


330

\_\_\_\_\_ Ft. from S. Line

\_\_\_\_\_ Ft. from E. Line

330

\_\_\_\_\_ Ft. from W. Line

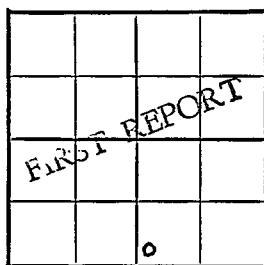

Rooks County

Core drill

Location \_\_\_\_\_

Rig up \_\_\_\_\_

Drilling and Remarks:

Spud 2-23-50

10" @ 204

Anhy 1445

drlg. 2161

## RECORD

Cased \_\_\_\_\_ in., \_\_\_\_\_ ft.

Sand \_\_\_\_\_

Gas \_\_\_\_\_

Oil \_\_\_\_\_

Total Depth \_\_\_\_\_

## PRODUCTION

1st 24 hrs. Nat. \_\_\_\_\_

1st 24 hrs. after shot \_\_\_\_\_

Gas \_\_\_\_\_ Cu. Ft.

Dry Hole \_\_\_\_\_

Abandoned \_\_\_\_\_

Date

MAR 1 1950J. E. TYRA

Scout

Kansas

Map No. \_\_\_\_\_ Sec. 13 Twp. 9 R. 18WWell No. 1 Daisy Burton

Continental

Company

Contractor

SW SW SE

E1. 2074  
SECTION PLAT


\_\_\_\_\_ Ft. from N. Line

330 Ft. from S. Line

\_\_\_\_\_ Ft. from E. Line

330 Ft. from W. Line*strat test well*

Rooks County

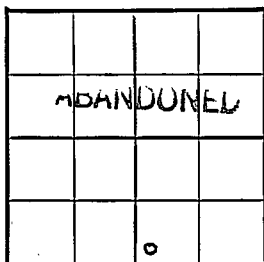

Location \_\_\_\_\_

Rig up \_\_\_\_\_

Drilling and Remarks:

*10" @ 204**Lans 3289**cong 3547**and 3618**D & A*

## RECORD

Cased \_\_\_\_\_ in., \_\_\_\_\_ ft.

Sand \_\_\_\_\_

Gas \_\_\_\_\_

Oil \_\_\_\_\_

Total Depth 3667

## PRODUCTION

1st 24 hrs. Nat. \_\_\_\_\_

1st 24 hrs. after shot \_\_\_\_\_

Gas \_\_\_\_\_ Cu. Ft.

Dry Hole \_\_\_\_\_

Abandoned \_\_\_\_\_

Date

MAR 15 1950

19

J. E. TYRA

Scout