

Rooks County

Barry Pool

FORM 51 5M 6-46 PETROL

KANSAS


Section 13 Township 9 Range 19W

Well No. 2 Hillgers

Company H. H. & B. Drlg.

2

NORTH

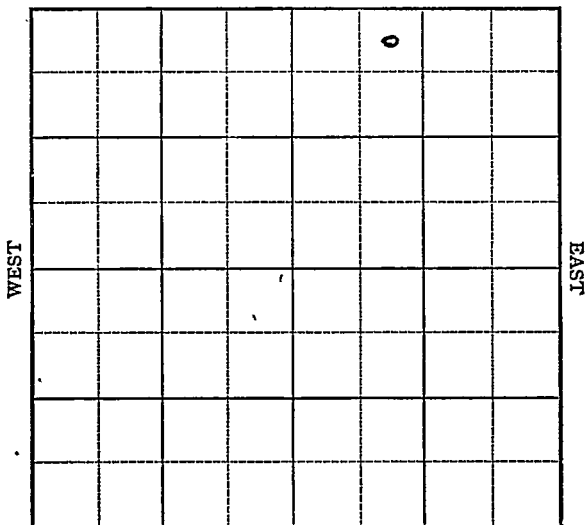

SOUTH

KANSAS

Rooked

Sec. 13 Twp. 9 R. 19-W

Well No. #2 Hillgers Farm

H. H. & B Drlg Company

Barry Pool

330 Ft. from N. Line


Ft. from S. Line

Ft. from E. Line

990 Ft. from W. Line

NE NW NE

Elev. 2079'

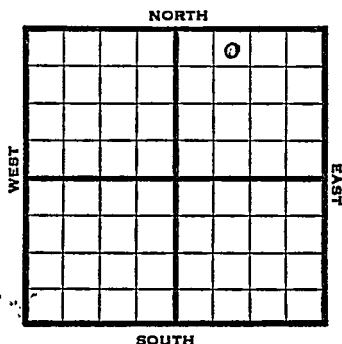

1947

REPORT

2/26 10" @ 202'
WOC

3/4 Anhy 1430
Drlg 2910'

3/11 Arb 3495-97
TD 3497'
5" @ 3495'
RUST

3/18 TD 3497'

3/25 TD 3503'
2000 Acid
Pump 110 bbls oil in 9 hrs 2% water

4/2 Arb. 3495'
5" @ 3495'
2000 Acid
Pump 324 Pot.
31.0 Gr.
TD 3503'.

COMPLETED

COMPLETED

Kansas

KANSAS

Barry Pool

Map No. 65 Sec. 13 Twp. 9 R. 19WWell No. 2 Hillgers

H. H. & B. Drlg. Company

FIRST REPORT

Contractor

NE NW NE

SECTION PLAT

		o	

330 Ft. from N. Line Ft. from S. Line Ft. from E. Line990 Ft. from W. Line

Rooks County

Location Rig up

Drilling and Remarks:

10" @ 202 WOC

RECORD

Cased in., ft.Sand Gas Oil Total Depth

PRODUCTION

1st 24 hrs. Nat. 1st 24 hrs. after shot Gas Cu. Ft.Dry Hole Abandoned

Date

FEB 26 1947 19

S. J. LEWIS Scout

Map No. K65 Sec. 13 Twp. 9 R. 19W

Well No. 2 Hillgers

H. H. & B. Drlg. Company

COMPLETE

Contractor

NE NW NE

E1,207

SECTION PLAT

330 Ft. from N. Line

 Ft. from S. Line

 Ft. from E. Line

990 Ft. from W. Line

		0	

Rooks County

Location

Rig up

Drilling and Remarks:

Q. Y3495

5" @ 3495

2000 acic

Prod 324 Bbl

31° 30'

RECORD

Cased in., ft.

Sand

Gas

Oil

Total Depth 3523

PRODUCTION

1st 24 hrs. Nat.

1st 24 hrs. after shot

Gas Cu. Ft.

Dry Hole

Abandoned

Date

APR 2 1947 19 S. J. LEWIS Scout