

KANSAS


Rooks

FORM 51 5M 6-46 PETROL

Section 13 Township 9 Range 19-W

Well No. #1 Hilgers

Company H.H. & B Drlg

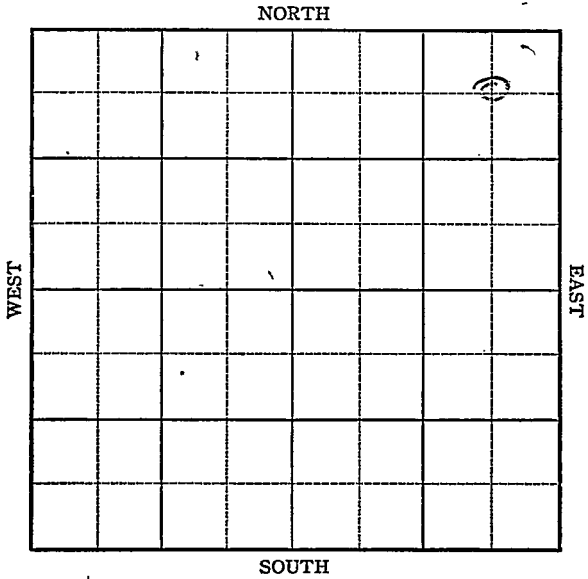

Sec. 13 Twp. 9 R. 19W

Well No. #1 Hilgers Farm

H. H. & B. Drlg. _____ Company

Barry

330 Ft. from N. Line


Ft. from S. Line

330 Ft. from E. Line

Ft. from W. Line

NE/c

NORTH

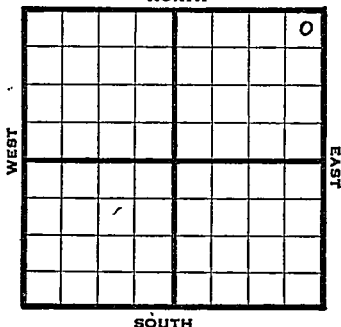

SOUTH

1946

206/

REPORT

8/21 | Anhy. 1420

Lens. 3237

Drlg. 3320'

8/27⁷ 10⁸ @ 248!

3452 fsg

9/5	11	11
-----	----	----

9/10 | Lans 3237

BKC 3 457

Arb 3479

TD 3484'

5" @ 3480 RUST

9/18 | 1000 acid

Swb 40 oil PH

9/24 " "

10/1	"	"
------	---	---

10/8 " "

10/16 | Arb 3479'

5" @ 3480'

1000 Acid

TD 3484'

Depth POT 2735 oil plus 6% W.

Grav. 27

COMPLETED

KANSAS

Kansas

Pool Name

Barry

Map No. 68 Sec. 13 Twp. 9 R. 19WWell No. 1 Hilgers

H. H. & B Drlg.


Company

FIRST REPORT

Contractor

NE/C

SECTION PLAT

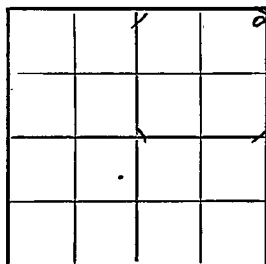330 Ft. from N. Line Ft. from S. Line330 Ft. from E. Line Ft. from W. Line

Rooks County

Location

Rig up

Drilling and Remarks:

Anhy 1420

Lans. 3237

drlg. 3320

RECORD

Cased in., ft.Sand Gas Oil Total Depth

PRODUCTION

1st 24 hrs. Nat. 1st 24 hrs. after shot Gas Cu. Ft.Dry Hole Abandoned

Date

AUG 21 1946 19

S. J. LEWIS

Scout

Map No. 62 Sec. 13 Twp. 9 R. 19W

Well No. 1 Hilgers

H H & B Drlg. Company

COMPLETED Contractor

NE/C


E1, 2061
SECTION PLAT

330 Ft. from N. Line

 Ft. from S. Line

330 Ft. from E. Line

 Ft. from W. Line

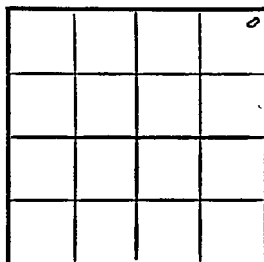

Rooks County

Location

Rig up

Drilling and Remarks:

Art 3479
5" @ 3480
1000 acid

Depth 282735 oil
46% W

27% Gr

RECORD

Cased in., ft.

Sand

Gas

Oil

Total Depth 3484

PRODUCTION

1st 24 hrs. Nat.

1st 24 hrs. after shot

Gas Cu. Ft.

Dry Hole

Abandoned

Date

OCT 16 1946 19 S. J. LEWIS Scout