

KANSAS Graham


Section 13 Township 9 Range 21WWell No. 2 BraultCompany Harbar

Morel Pool

NORTH

WEST

EAST

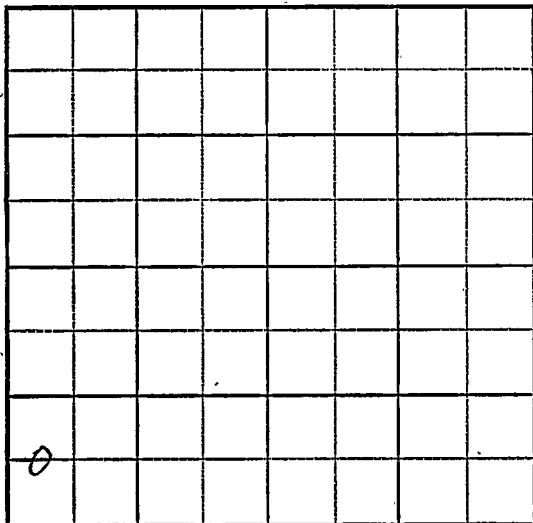

SOUTH

Sec. 13 Twp. 9 R. 21W ✓

Well No. 2 Brault Farm

Harbar Company

Morel Pool


 Ft. from N. Line

660 Ft. from S. Line

 Ft. from E. Line

330 Ft. from W. Line

C W L SW SW

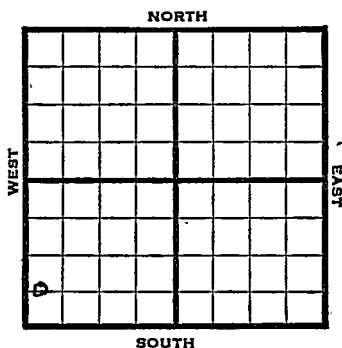

1948

Elev. 2197' REPORT

9/22

10" @ 90'

Anhy. 1690'

Drilling 3675'

9/29

TD 3775'

10/6


Arbuckle 3739'

TD 3777'

ABANDONED

Graham County Kansas StateMap No. _____ Sec. 13 Twp. 9 R. 21WWell No. 2 BraultHarbar Company**FIRST REPORT**

Contractor

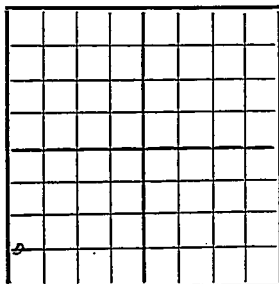C W L SW SW**SECTION PLAT** Ft. from N. Line660 Ft. from S. Line Ft. from E. Line330 Ft. from W. LineMorel Pool

Remarks:

10" @ 90 Anhy 1690 drlg. 3675

Date
SEP 22 1948Scout
S. J. LEWIS

Map No. 65 Sec. 13 Twp. 9 R. 21W

Well No. 2 Brault

Har bar Company

ABANDONED

Contractor

C W L SW SW

E. 2192

SECTION PLAT

 Ft. from N. Line

660 Ft. from S. Line

 Ft. from E. Line

330 Ft. from W. Line

0			

Graham County

Location

Rig up

Drilling and Remarks:

Ar 83287

RECORD

Cased in., ft.

Sand

Gas

Oil

Total Depth 8222

PRODUCTION

1st 24 hrs. Nat.

1st 24 hrs. after shot

Gas Cu. Ft.

Dry Hole

Abandoned

Date

OCT 6 1948 19 S. I. LEWIS Scout