

Graham

KANSAS

SEC.	13	TWP.	9S	R.	21W
WELL NO.					
7 Richman					
FARM					
COMPANY					
D. G. Hansen					
CONTRACTOR					


Morel North Pool

_____ Ft. from N. Line

_____ Ft. from S. Line

_____ Ft. from E. Line

_____ Ft. from W. Line

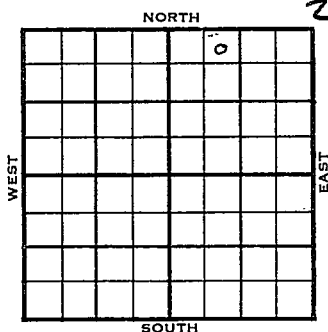

NE NW NE

	ELEVATION	REPORT
1955	2158'	
5/25	Heeb 3388; Tor 3407; Lsg 3430; BKC 3642; Congl 3710; TD 3813, 8" 166, no log D&A	FIRST REPORT + ABANDONED