


Section 13 Township 9 Range 22^W

Well No. 1 Buss "D"

Company Anderson-Pritchard

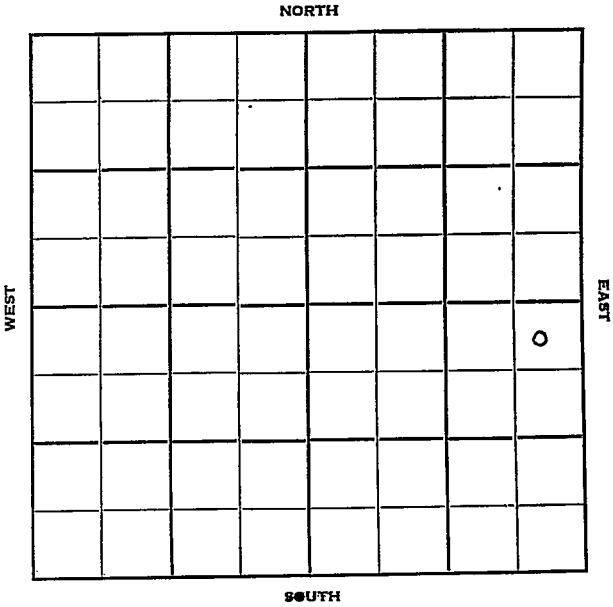

Graham

KANSAS

Sec. 13 Twp. 9 R. 22 W

Well No. # 1 Buss "D" Farm

Anderson-Prichard Company

Contractor

Morel Pool


330 Ft. from N. Line

Ft. from S. Line

330 Ft. from E. Line

Ft. from W. Line

NE NE SE

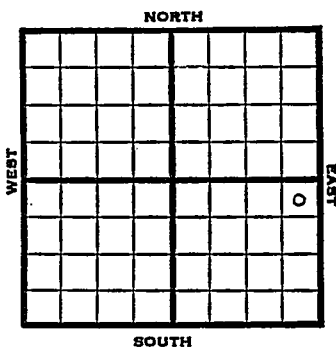

1951

Elev. 2281' REPORT

8/1 Cellar & Pits

9/19 Spud 8-1-51
 Oil well TD 3797' 8" @ 258
 Anhy 1745' Heeb 3447' KC 3486'
 DST 3480-3545 open 30 min. rec 734'
 SGCSW 3' free oil
 Arb. 3795-97' 5" @ 3796'
 TD 3797' S/7 BOPH
 Comp. 144 BOPD

• COMPLETED

