

Section 13 Township 9 Range 22W

Well No. #3 Buss (D)

Company Anderson-Prichard Oil Co.

A 10x10 grid with 'NORTH' at the top, 'SOUTH' at the bottom, 'WEST' on the left, and 'EAST' on the right. A small circle is in the bottom-right cell.

Graham

KANSAS

Sec. 13 Twp. 9 R. 22W ✓

Well No. #3 Buss (D) Farm

Anderson-Prichard Oil Co. Company

Peel - Contr. Contractor

Morel Pool


Ft. from N. Line

990' Ft. from S. Line

330' Ft. from E. Line

Ft. from W. Line

NE SE SE

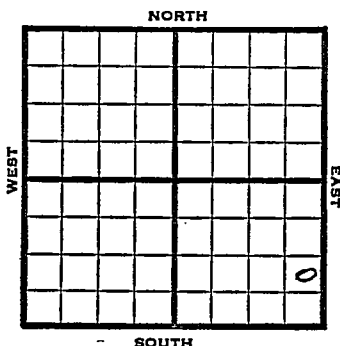

1951

Elev. 2275' REPORT


9/12

Spud 9-6-51
8" @ 247'
Anhy 1785
Drlg. 2580'

9/19

Spud 9-6-51
D & A TD 3890' 8" @ 247
Anhy 1785' Heeb 3456' Lans 3495'
Cong 3783' Arb. 3830'
DST 3831-39 open 40 min. rec 20' mud
TD 3890' D & A
ABANDONED

J. E. TYRA

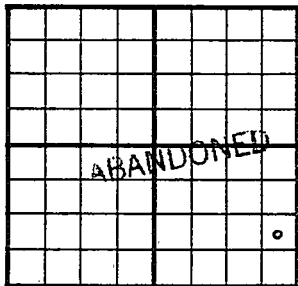County Graham State KansasSec. 13 (Blk.
Twp.) 9 (Sur.
Rge.) 22W Map No.Operator Anderson-PrichardWell No. 3 Farm Buss "D"Elev. 2275 Location NE SE SE990 Ft. From S Line SE330 Ft. From E Line Quarter

1st. Report

Completion SEP 19 1951Remarks Morel PoolPeel Drlg. - Contr.Spudding Date 9-6-51Drlg. Data D & A TD 38908" @ 247 Anhy 1785 Heeb. 3456Lans. 3495 Cong. 3783 Arb. 3830DST 3831-39 open 40 min. Rec. 20' mudTD 3890 D & A

J. E. TYRA