


Section 13 Township 9 Range 22W

Well No. 2 Buss "C"

Company Anderson-Pritchard

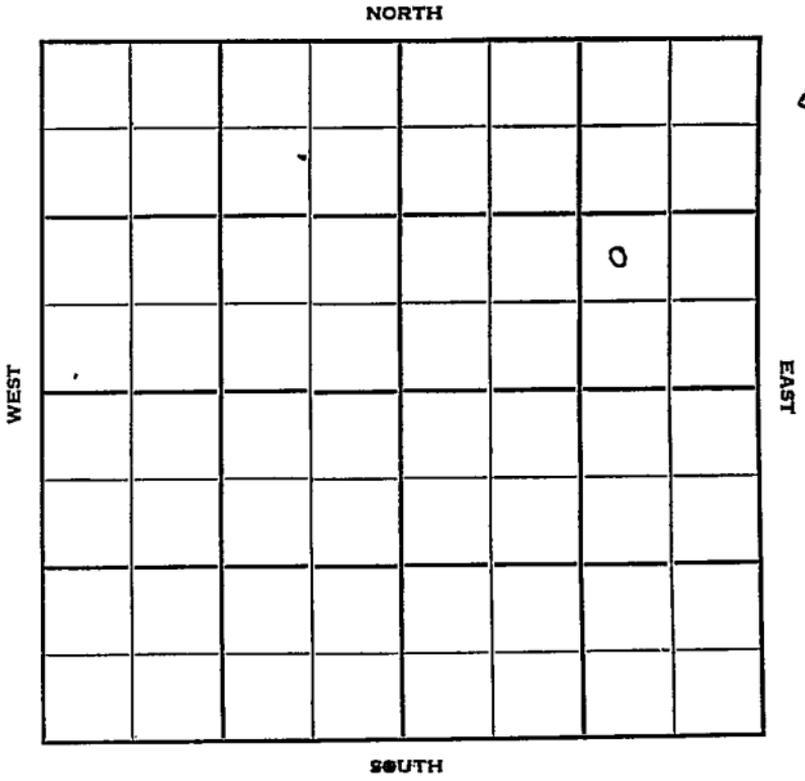

Elev 2266'

o

TD - 1525'

PB

CSG. 54-1517


PF

11°P 142BOPP

C. 8-29-51

2075 - 1214

Arb. - 1514

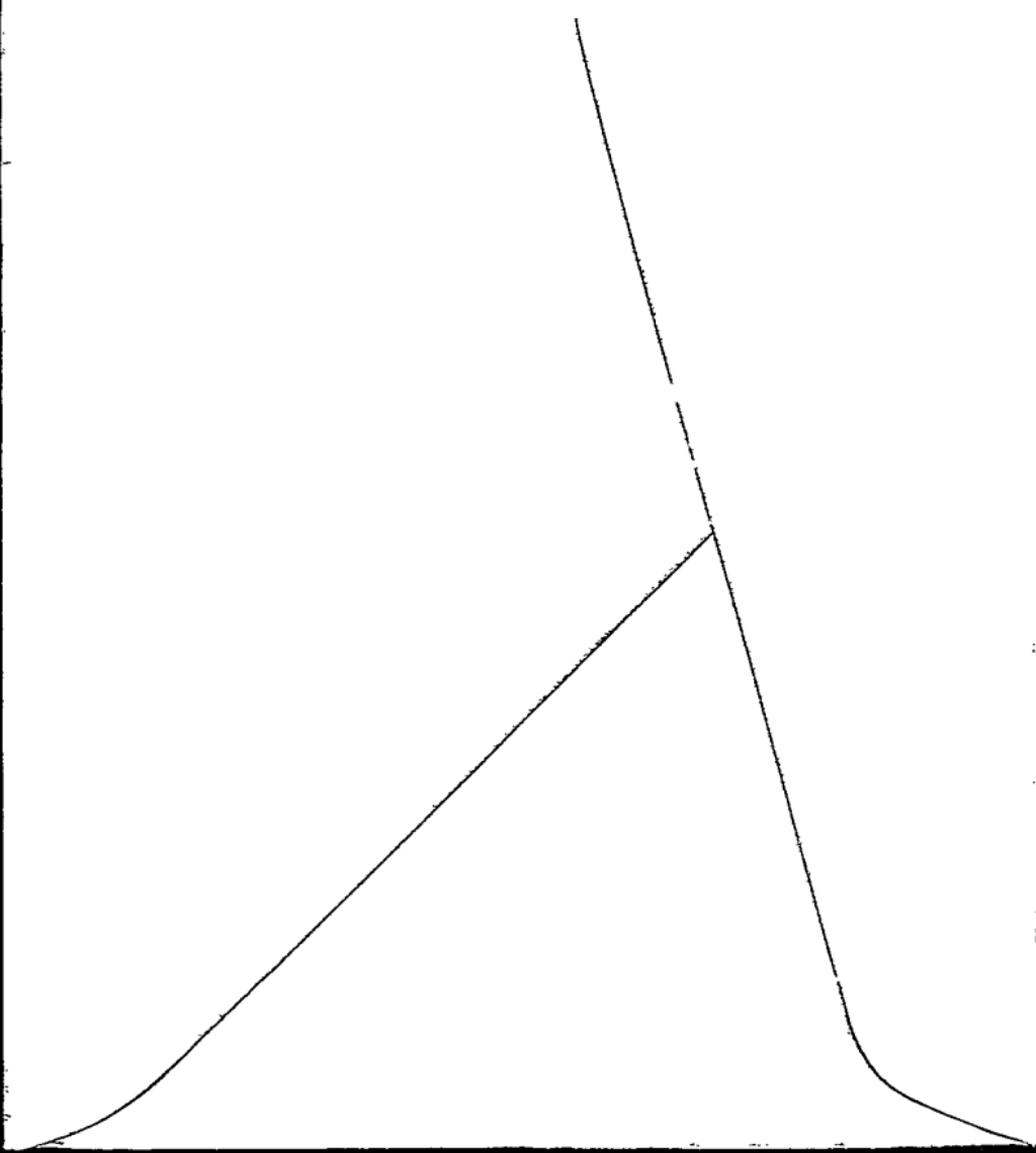

Graham

KANSAS

Sec. 13 Twp. 9 R. 22 W ✓

Well No. # 2 Buss "C" Farm

Anderson-Prichard Company

Jones, Shelborne & Farmer Contractor

Morel Pool


\_\_\_\_\_ Ft. from N. Line

990 Ft. from S. Line

990 Ft. from E. Line

\_\_\_\_\_ Ft. from W. Line

NW SE NE

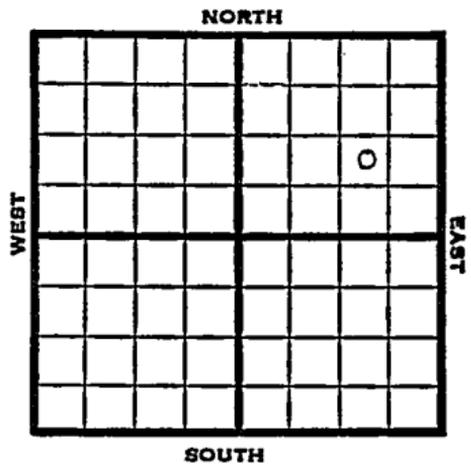

1951

Elev. 2266'

REPORT

7/25

Spud 7-21-51

8" @ 256

Anhy 1770'

Drlg. 2280'

8/29

Spud 7-21-51

Oil Well TD 3791

8" @ 256

Anhy 1770 Heeb. 3434

Lans. 3470 Arb. 3780

TD 3791 5" @ 3783

CO to 3791 S/130 bo 4 bw 12 hrs.

P/71 bo 12 hr Comp. 169 bopd

15% wtr.

**COMPLETED**

County Graham State Kansas

Sec. 13 (Blk. Twp.) 9 (Sur. Rge.) 22W Map No.

Operator Anderson-Prichard

Well No. 2 Farm Buss "C"

Elev. 2266 Location NW SE NE

FIRST REPORT					
				0	

990 Ft. From S Line NE

990 Ft. From E Line Quarter

Ist. Report JUL 25 1951

Completion \_\_\_\_\_

Remarks \_\_\_\_\_

Jones, Shelborne & Farmer

Spudding Date 7-21-51 contr.

Drlg. Data Morel Pool

8" @ 256 Anhy 1770 Drlg. 2280

J. E. TYRA

