


Section 13 Township 9 Range 22 WWell No. # 1; Buss "C"Company Anderson-Prichard

NORTH

WEST

EAST

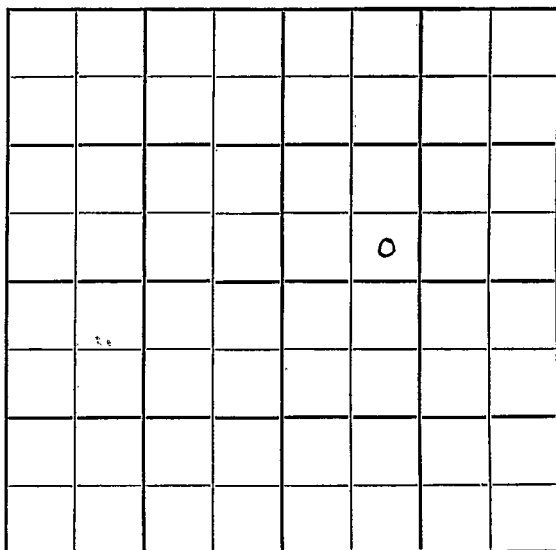

SOUTH

Graham

KANSAS

Sec. 13 Twp. 9 R. 22W ✓

Well No. #4 Buss "C" Farm

Anderson-Prichard Company

Peel Drlg. Contractor

Morel Pool

Ft. from N. Line

330


Ft. from S. Line

Ft. from E. Line

990

Ft. from W. Line

SE SW NE

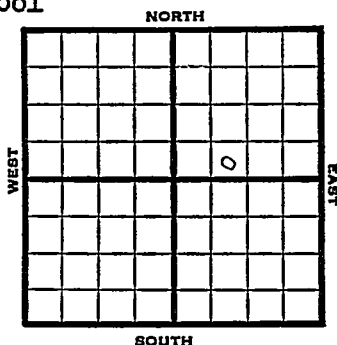

1951 Elev. 2277' REPORT

10/3 Spud 9-28-51
8 5/8" @ 252
1665' Anhy
Drlg. 1900'

10/24 Spud 9-28-51
D&A TD 3807'
8-5/8" @ 252'
Anhy 1665' Heeb. 3451 Lans. 3490
Arb. 3803
Cored 3803-07 SO
5" @ 3804 CO to 3807
B/ 3/4 BOPH 250 A S/ 1 boph
40 BWPH 2 hr. S/ 2 BOPH 50 BWPH
11 hr. PB 3804 20/ 3799-3804
B/ 7 GW 1 GOPH 9/ 3804-05
250 A S/ 40 BW 1 1/2 BOPH
D&A

ABANDONED

J. E. TYRA

Sec.	13	(Blk. Twp.)	9	(Sur. Rge.)	22W	Map No.
------	----	----------------	---	----------------	-----	---------

Well No. 4 Farm Buss "C"

Elev.	2277	Location	SE SW NE
-------	------	----------	----------

ABANDONED

990 Ft. From W Line Quarter

Ist. Report

Completion OCT 24 1951

Remarks	Morel Pool
---------	------------

Peel Drlg. - Contr.

Spudding Date 9-28-51

Drig. Data D & A TD 3807

8 5/8" @ 252 Anhy 1665 Heeb. 3451

Lans. 3490 Arb. 3803. Cored 3803-07

SO 5" @ 3804 CO to 3807 B/ 3/4 boph

250 A S/ 1 boph 40 bwph 2 hr.

S/ 2 bwpb 50 bwph 11 hr. PB 3804

20/ 3799-3804 B/ 7 gw 1 goph

9/ 3804-05 250 A S/ 40 bw 1½ boph

D & A

J. E. TYRA