


Section 13 Township 9 Range 22W

Well No. #2 Buss "D"

Company Anderson-Prichard

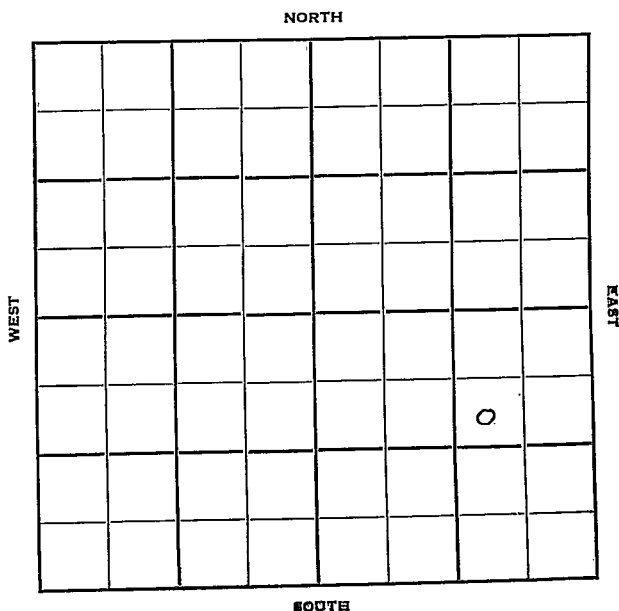

Graham

KANSAS

Sec. 13 Twp. 9 R. 22 W ✓

Well No. # 2 Buss "D" Farm

Anderson-Prichard Company

Peel Drlg. Contractor


Morel Pool

990 Ft. from N. Line

 Ft. from S. Line

990 Ft. from E. Line

 Ft. from W. Line

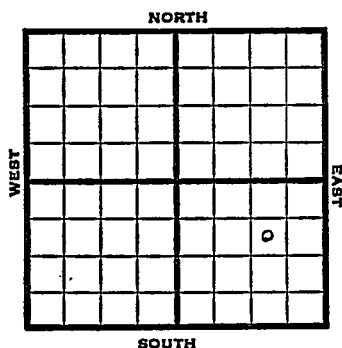

SW NE SE

1951

Elev. 2275' REPORT

8/15

Location

9/19

Spud 8-15-51

Oil well TD 3802' 8" @ 250

Anhy 1795' Heeb 3448' KC 3488'

DST 3571-81' open 25 min. rec 240'


water, 650' mud

Arb. 3799-3802' 5" @ 3801'


CO to 3802' S/76 BO 13 hr.

Comp. 143 BOPD

COMPLETED

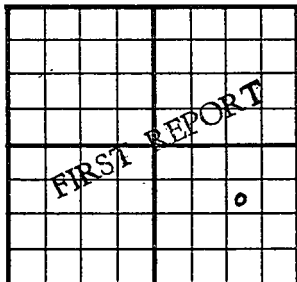County Graham State KansasSec. 13 (Blk.) 9 (Sur.) 22W Map No.Operator Anderson-PrichardWell No. 2 Farm Buss "D"Elev. Location SW NE SE990 Ft. From N Line SE990 Ft. From E Line Quarter1st. Report AUG 15 1951CompletionRemarksPeel Drlg. - Contr.Spudding DateDrlg. Data Morel PoolLocation

County Graham State Kansas
 Sec. 13 (Blk.) 9 (Sur.) 22W Map No. _____
 Operator Anderson-Prichard
 Well No. 2 Farm Buss "D"
 Elev. 2275 Location SW NE SE

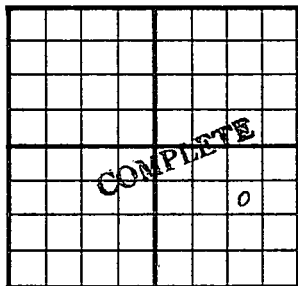

990 Ft. From N Line SE
990 Ft. From E Line Quarter
 Ist. Report _____
 Completion SEP 19 1951
 Remarks Morel Pool
Peel Drlg. - Contr.
 Spudding Date 8-15-51

Drlg. Data Oil well TD 3802
8" @ 250 Anhy 1795 Heeb. 3448
KC 3488 DST 3571-81 open 25 min.
Rec. 240' water 650' mud Arb. 3799-3802
5" @ 3801 CO to 3802 S/ 76 bo 13 hr.
Comp. 143 bopd