


Section 13 Township 9 Range 23 W

Well No. #1 Marshall Law "A"

Company Transit Corp. & Oil Trading & SDX  $\frac{1}{2}$

NORTH

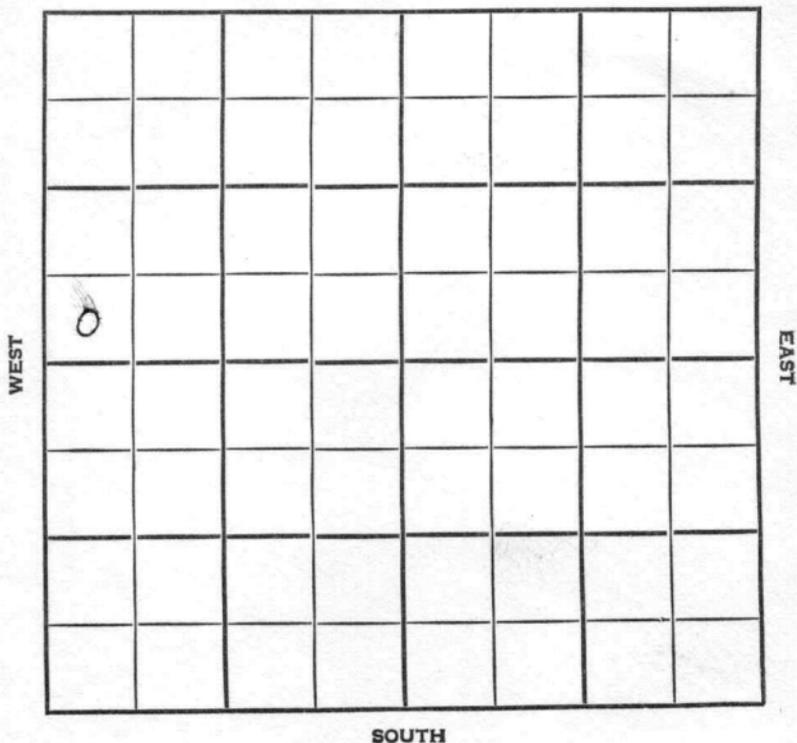

# HOT FILE

Graham

KANSAS

SEC.	TWP.	R.
13	9	23 W

WELL NO.

# 1 Marshall Law "A"

FARM

COMPANY

Transit Corp & Oil Trading &  
Sunray Mid-Continent--1/2

CONTRACTOR

## Wildcat


\_\_\_\_\_ Ft. from N. Line

\_\_\_\_\_ Ft. from S. Line

\_\_\_\_\_ Ft. from E. Line

\_\_\_\_\_ Ft. from W. Line

SW SW NW

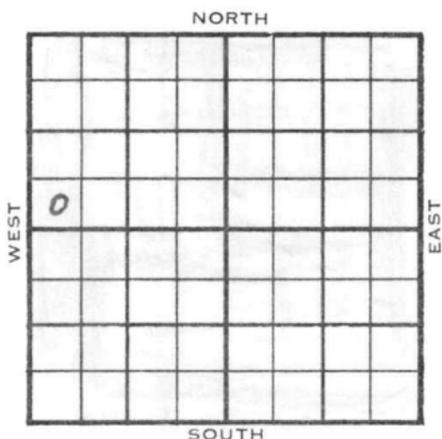

1955

ELEVATION

2346'

REPORT

(TWH5-F05)

9/7

Comm. 8-31-55  
8" @ 140 w/100  
Drlg. 2600'

9-8

" " "

9/14

8" @140/100  
DST 3772-92 open 1 hr rec 8' mud. 100'  
DST 3798-3830, open 80 min, rec 30'  
OCM, 140' VHOCM 1275# TD 3900'  
D & A  
Tops: H. 3616', Tr. 3640', KC 3653'  
LOG: H. 3614', Tr. 3635', KC 3648'  
B KC 3874'

**ABANDONED**

County Graham Elev. \_\_\_\_\_  
 Sec. 13 Twp. 9 Rge. 23W  
 Company Transit Corp & Oil Trading & Sunray <sup>1/2</sup> MO  
 Farm Name Marshall Law "A" No. 1

TOPS	DEPTH	LOG	DATUM
Anh.			
Tp.			
H.			
Tr.			
Dg.			
B.L.			
L.			
K.C.			
B.K.C.			
Ce.			
C.			
M.			
M.			
K.			
Mz.			
Me.			
V.			
S.			
S.			
A.			
R.			
Pe.			
G.			
T.D.			

Loc. in Sec. SWSW NW

Geol. \_\_\_\_\_  
 Contr. \_\_\_\_\_

Pool Wildcat

**FIRST REPORT**  
 SEP 7 '55

Date Comm. 8-31-55  
8" @ 140/100 drlg. 2600

\_\_\_\_\_  
 \_\_\_\_\_  
Co.  
 Lse.  
 No.  
 Sec.  
 T.  
 R.

County Graham Elev. 2346  
 Sec. 13 Twp. 9 Rge. 23W  
 Company Transit Corp & Oil Trading & Sunray  
 Farm Name Marshall Law "A" No. 1 MC

TOPS	DEPTH	LOG	DATUM
Anh.			
TP.			
H.	3616	3614	1268
Tr.	3640	3635	1289
Dg.			
Bl.			
L.			
K.C.	3653	3648	1302
B.K.C.		3874	
Ce.			
C.			
M.			
M.			
K.			
Mz.			
Me.			
V.			
S.			
S.			
A.			
R.			
PE.			
G.			
TD.	3900		

Loc. in Sec. SW SW NW

Geol. \_\_\_\_\_  
 Contr. \_\_\_\_\_

Pool Wildcat



Date Comm. SEP 14 1955  
8" @ 140/100 DST 3772-92 open 1 hr.  
Rec. 8' mud 100# DST 3798-3830  
open 80 min. Rec. 30' ocm 140' vhocm  
1275# TD 3900  
D & A

Co.  
Lse.  
No.  
Sec.  
T.  
R.