

DX 78-1


Thomas

KANSAS
33 W

Section 13 Township 9 S Range 33 W

Well No. # 1 Frantz

Company Texota Oil & Bennett & Roberts

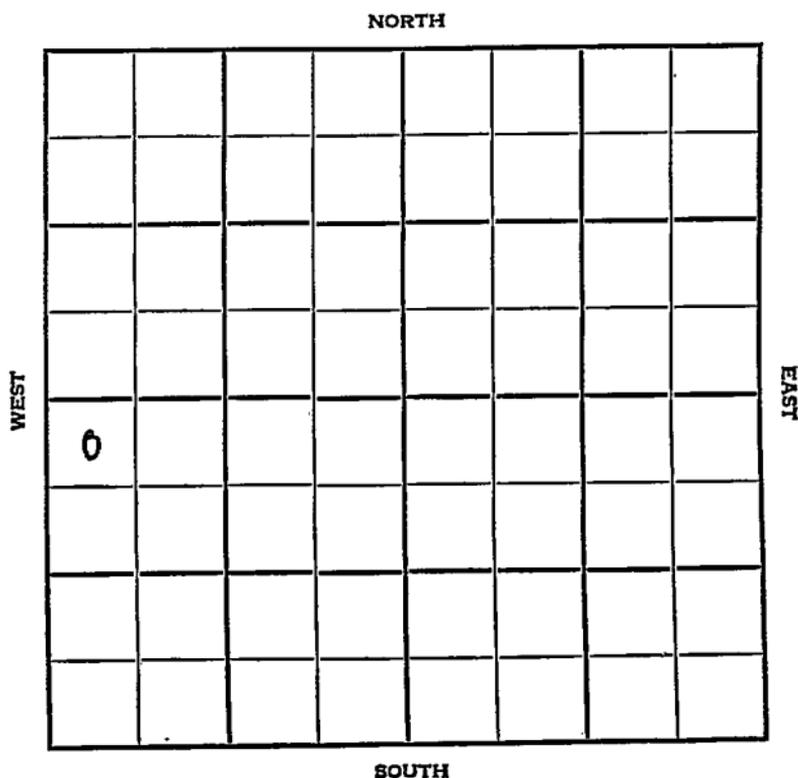

Thomas


SEC.	TWP.	R.
13	9 S	33 W

WELL NO. # 1 Frantz FARM

COMPANY Texota Oil & Bennett & Roberts

CONTRACTOR B & R Drlg.

Wildcat


330 Ft. from N. Line

Ft. from S. Line

Ft. from E. Line

330 Ft. from W. Line

NW NW SW

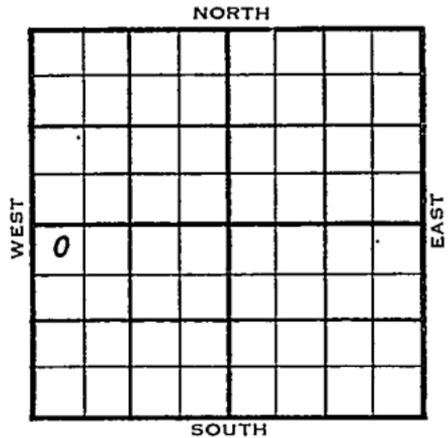

1954	ELEVATION	REPORT
	3098'	
12/8	Spud 12-2-54 8" @ 313 Drlg. 2475'	
12/22	Spud 12-2-54 D & A TD 4810' 8" @ 313' Heeb 4051', Lans 4090' BKC 4405' Marm 4430' DST 4650'-65' opn 1 hr, rec 5' Mud 400# Miss 4667' DST 4723'-70' opn 1 hr, rec 75' Muddy Wtr, 1000# TD 4810' D & A	ABANDONED

County Thomas State Kansas

Sec. 13 (Blk. 9S) (Sur. Rge.) 33W Map No.

Operator Texota Oil & Bennett & Roberts

Well No. 1 Farm Frantz

Elev. - Location NW NW SW

330 Ft. From N Line

330 Ft. From W Line SW Quarter

Ist. Report DEC 8 1954

Completion

Remarks B & R tools

Spudding Date 12-2-54

Drig. Data Wildcat

8" @ 313 Drig. 2475

FABEN GILSTRAP

