

KANSAS


FORM 51 5M 10-41 PETROL

Rooks

Section 14 Township 9 Range 16-W

Well No. #1 Blank


Company Vickers
(Laton)

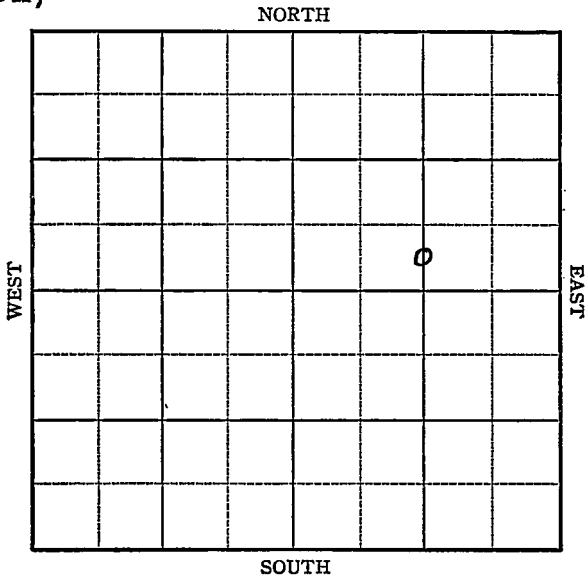

Map No. 64 Sec. 14 Twp. 9 R. 16WWell No. 1 BlankVickers Company~~FIRST REPORT~~ Contractor

C SL NE

SECTION PLAT

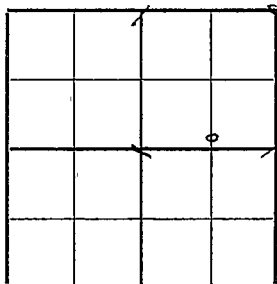 Ft. from N. Line330 Ft. from S. Line Ft. from E. Line1320 Ft. from W. Line

LATON POOL

RECORD

Location Cased in., ft.Rig up Sand Drilling and Remarks: Gas Oil Total Depth

Derri ck

PRODUCTION

1st 24 hrs. Nat. 1st 24 hrs. after shot Gas Cu. Ft.Dry Hole Abandoned

Date

DEC 1 0 1941 19 S. J. LEWIS Scout

Map No. 64 Sec. 14 Twp. 9 R. 16WWell No. 1 BlankVickers

Company

COMPLETED

Contractor

C SL NE

SECTION PLAT

 Ft. from N. Line330 Ft. from S. Line1320 Ft. from E. Line Ft. from W. Line

LATON POOL

RECORD

Location Cased in., ft.Rig up Sand

Drilling and Remarks:

Gas Oil Total Depth 3367

PRODUCTION

1st 24 hrs. Nat. 1st 24 hrs. after shot Gas Cu. Ft.Dry Hole Abandoned

Date

JAN 21 1942

19

S. J. LEWIS

Scout

Have 8294
 5" @ 3315.
 8000 acid
 Pump 244 B.S.

35° S