

Map No. _____ Sec. 14 Twp. 9 R. 16 w

Well No. 67 Blank Farm

Stearns + Strumann Company

WEST

EAST

SOUTH

Location

Drilling Remarks

Rig Up_____

Drilling Remarks

RECORD

Cased.....in.ft.

Sand _____

Gas -----

Oil _____

Total Depth.....°

PRODUCTION

1st 24 hrs. Nat.

1st 24 hrs. after shot.....

Gas..... cu. ft.

Dry Hole.....

Abandoned


KANSAS

Map No. _____ Sec. 14 Twp. 9 R. 16WWell No. 1-Blank Farm _____Stearns & Streeter Company330 Ft. from N. Line

_____ Ft. from S. Line

330 Ft. from E. Line330 Ft. from W. Line1928

NORTH

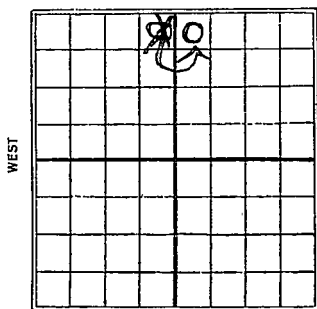

SOUTH

Date

REPORT

<u>3/7</u>	<u>Location</u>
<u>3/14</u>	<u>Rig,</u>
<u>3/21</u>	<u>—</u>
<u>3/28</u>	<u>Rig</u>
<u>4/11</u>	<u>—</u>
<u>4/11</u>	<u>—</u>
<u>4/18</u>	<u>Rigging up-</u>
<u>4/25</u>	<u>Spud</u>
<u>5/2</u>	<u>Drlg 900</u>
<u>5/9</u>	<u>—</u>
<u>5/16</u>	" <u>1138</u>
<u>5/23</u>	" <u>1560</u>
<u>5/31</u>	" <u>2385</u>
<u>6/6</u>	" <u>2440</u>
<u>6/13</u>	<u>T.D. 2885 - U.R. 8"</u>
<u>6/20</u>	<u>Drlg 2960</u>
<u>6/27</u>	<u>T.D. 2965 - Cen 8"</u>
<u>7/3</u>	<u>Top Oswald 3229 - drlg 3229-</u>
<u>7/11</u>	<u>drlg 3400'</u>
<u>7/18</u>	<u>Run'g 5" @ 3452</u>
<u>7/25</u>	<u>Drlg 3540-</u>
<u>8/1</u>	<u>Run'g 5" @ 3548-</u>

8/7-HFW 3620 TD-P.B.D 3300

8/5-T.D. 3620 H.F.W.

N. + Q. 3620'

Map No. KANSAS Sec. 14 Twp. 9 R. 16 W

Well No. 1 Blank

Stearns & Streeter Company

Contractor

SECTION PLAT

	0		

330 Ft. from N. Line

----- Ft. from S. Line

330 Ft. from E. Line

----- Ft. from W. Line

FIRST REPORTS

Location ✓

Rig up -----

Drilling and Remarks:

RECORD

Cased ----- in., ----- ft.

Sand -----

Gas -----

Oil -----

Total Depth -----

PRODUCTION

1st 24 hrs. Nat. -----

1st 24 hrs. after shot -----

Gas ----- Cu. Ft.

Dry Hole -----

Abandoned -----

Date

MAR 7 1928 S. J. LEWIS Scout

Map No. KANSAS Sec. 14 Twp. 9 R. 16 W

Well No. Blank

Stearns & Streeter Company

Contractor

SECTION PLAT

330 Ft. from N. Line

_____ Ft. from S. Line

_____ Ft. from E. Line

330 Ft. from W. Line

		0	

Correction

Location _____

Rig up _____

Drilling and Remarks:

Reported to be
in NE NW
should be
NW NE

RECORD

Cased _____ in., _____ ft.

Sand _____

Gas _____

Oil _____

Total Depth _____

PRODUCTION

1st 24 hrs. Nat. _____

1st 24 hrs. after shot _____

Gas _____ Cu. Ft.

Dry Hole _____

Abandoned _____

Date

MAR 14 1928

S. J. LEWIS

Scout

MAP No. KANSAS SEC. 14 TWP. 9 R. 16W

WELL No. Blank

Stearns & Streeter COMPANY

CONTRACTOR

SECTION PLAT

		0	

330 FT. FROM N. LINE

FT. FROM S. LINE

FT. FROM E. LINE

330 FT. FROM W. LINE

ABANDONED

LOCATION _____

RIG UP _____

DRILLING AND REMARKS:

Total depth
3620 AFW

I & H

RECORD

CASED _____ IN. _____ FT.

SAND _____

GAS _____

OIL _____

TOTAL DEPTH _____

PRODUCTION

1ST 24 HRS. NAT. _____

1ST 24 HRS. AFTER SHOT _____

GAS _____ CU. FT.

DRY HOLE _____

ABANDONED _____

DATE

AUG 15 1928

192

S. J. LEWIS

SCOUT