


Section 14 Township 9 Range 16 W

Well No. 4 #1 G. F. Brown

Company Battin & Wheeler Kueger

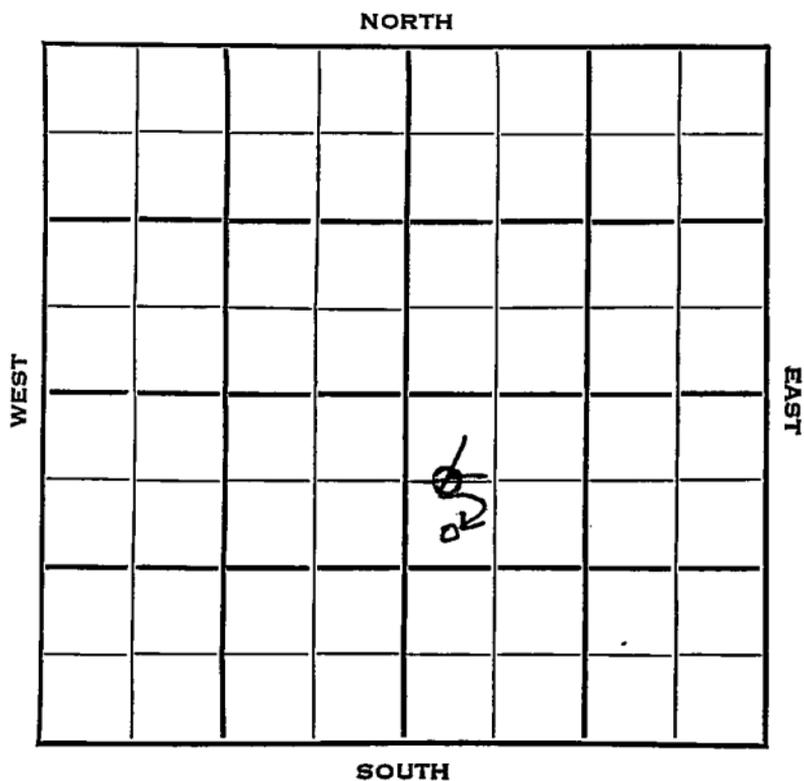

Rooks

KANSAS


SEC. 14	TWP. 9	R. 16W	✓
------------	-----------	-----------	---

WELL NO. ~~5~~ #4
1 G.F. Brown FARM

COMPANY ~~Kueger~~
~~Battin & Wheeler~~

CONTRACTOR
Needer

990 Laton Pool
660 Ft. from N. Line
Ft. from S. Line
Ft. from E. Line
330 Ft. from W. Line
SW
~~C W I~~ NW SE

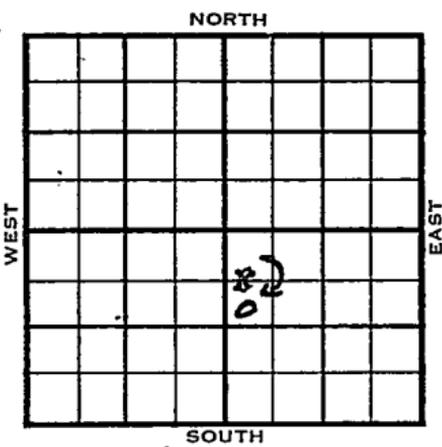

	ELEVATION	REPORT
1953	2081'	
10/21	C & P	
10/28	10" @ 125 Drlg. 2977'	
11/4	Anhy 1290 Top 2968 Heeb 3193 Tor 3213 Doug 3226 Lans 3234 DST 3337-47, 1 hr, 35' M 60# TD 3496 Schl 5" @ 3496	
11/11	NR	
11/18	NR	
12/16	NR	
1954		
1/6	NR	
1/13	"	
1/20	NR	
2/10	NR	
3/10	"	
3/17	"	

OVER

1954

3/24

Spud 10-20-53

Oil Well

TD 3496'

10" @ 125'

Anhy 1290', Top 2968', Heeb 3193',

Tor 3213', Doug 3226', Mans 3234'

DST 3337-47', opn 1hr., rec. 35' mud,
60#

TD 3496

5" @ 3496'

CO to 3457

15/3389-91 dry

9/3298-3301, 2500A

S/2 boph

S/33 bo 17 hrs.

Comp. 30 BOPD

COMPLETED

Kansas

Map No. _____ Sec. 14 Twp. 9 R. 16WWell No. 5 G. F. BrownBattin & Wheeler CompanyCORRECTION Contractor

SW NW SE

SECTION PLAT

990 Ft. from N. Line

_____ Ft. from S. Line

_____ Ft. from E. Line

330 Ft. from W. Line

		25	

Rooks County

Location _____

Rig up _____

Drilling and Remarks:

Reported

C W L NW SE

RECORD

Cased _____ in., _____ ft.

Sand _____

Gas _____

Oil _____

Total Depth _____

PRODUCTION

1st 24 hrs. Nat. _____

1st 24 hrs. after shot _____

Gas _____ Cu. Ft.

Dry Hole _____

Abandoned _____

Date _____

OCT 28 1953
19J. G. McGEHEE

Scout

Kansas

Map No. _____ Sec. 14 Twp. 9 R. 16WWell No. 5 Brown_____
Krueger Company_____
CORRECTION Contractor

SW NW SE

SECTION PLAT

990 Ft. from N. Line

_____ Ft. from S. Line

_____ Ft. from E. Line

330 Ft. from W. Line

		o	

Rooks County

Location _____

Rig up _____

Drilling and Remarks:

Reported
Battin & Wheeler

RECORD

Cased _____ in., _____ ft.

Sand _____

Gas _____

Oil _____

Total Depth _____

PRODUCTION

1st 24 hrs. Nat. _____

1st 24 hrs. after shot _____

Gas _____ Cu. Ft.

Dry Hole _____

Abandoned _____

Date

NOV 4 1953

J. G. McGEHEE
Scout

Map No. _____ Sec. 14 Twp. 9 R. 16W

Well No. 4 G. F. Brown

Krueger Company

CORRECTION

Contractor

SW NW SE

SECTION PLAT

990 Ft. from N. Line

_____ Ft. from S. Line

_____ Ft. from E. Line

330 Ft. from W. Line

		0	

Rooks County

Location _____

Rig up _____

Drilling and Remarks:

Reported
#5 Brown

RECORD

Cased _____ in., _____ ft.

Sand _____

Gas _____

Oil _____

Total Depth _____

PRODUCTION

1st 24 hrs. Nat. _____

1st 24 hrs. after shot _____

Gas _____ Cu. Ft.

Dry Hole _____

Abandoned _____

Date

DEC 2 1929

J. G. McGEHEE

Scout

County _____ Rocks _____ State Kansas

Sec. 14 (^{Blk.}Twp.) 9 (^{Sur.}Rge.) 16W Map No. _____

Operator Krueger

Well No. 4 Farm G. F. Brown

Elev. 2081 Location SW NW SE

COMPLETE

990 Ft. From N Line SE

330 Ft. From W Line Quarter

1st. Report _____

Completion MAR 24 1954

Remarks Laton Pool

Veeder - Contr.

Spudding Date 10-20-53

Drlg. Data Oil well TD 3496

10" @ 125 Anhy 1290 Top. 2968

Heeb. 3193 Tor. 3213 Doug. 3226

Lans. 3234 DST 3337-47 open 1 hr.

Rec. 35' mud 60# TD 3496 5" @ 3496

CO to 3457 15/ 3389-91 dry 9/ 3298-

3301 2500 A S/ 2 boph S/ 33 bo 17 hr.

Comp. 30 bopd

J. G. McGEHEE