

KANSAS Rooks

Sec. 14 Twp. 9 R. 17W ✓

Well No. 1 Westhusin Farm

Harbar Drlg. Company


Westhusin Pool

330 Ft. from N. Line

_____ Ft. from S. Line

330 Ft. from E. Line

_____ Ft. from W. Line

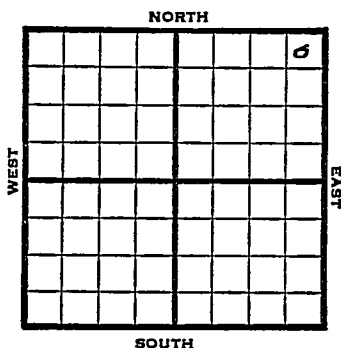

NE/C

1948

Elev 2056'

R E P O R T

11/17

8" @ 98'

11/23

Drlg 2230'

11/30

Drlg 3155'

12/8

TD 3500'

12/15

TD 3500'

Lans. 3191'

Arb 3472'

Aband.

ABANDONED

Map No. _____ Sec. 14 Twp. 9 R. 17WWell No. 1 Westhusin

Harbar Drlg. _____ Company _____

FIRST REPORT

Contractor _____

NE/C


SECTION PLAT

330 Ft. from N. Line

_____ Ft. from S. Line

330 Ft. from E. Line

_____ Ft. from W. Line

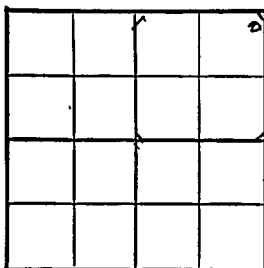

Rooks County

Location _____

Rig up _____

Drilling and Remarks:

8" @ 98'

RECORD

Cased _____ in., _____ ft.

Sand _____

Gas _____

Oil _____

Total Depth _____

PRODUCTION

1st 24 hrs. Nat. _____

1st 24 hrs. after shot _____

Gas _____ Cu. Ft.

Dry Hole _____

Abandoned _____

Date

NOV 17 1948 19

S. J. LEWIS Scout

Map No. 64 Sec. 14 Twp. 9 R. 17WWell No. 1 Westhusin

Harbar Drlg.

Company

ABANDONED

Contractor

NE/C

E/2056


SECTION PLAT

330 Ft. from N. Line

Ft. from S. Line

330 Ft. from E. Line

Ft. from W. Line

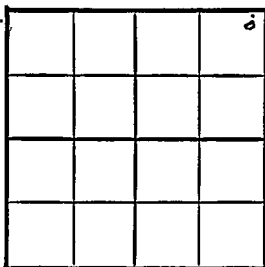

Rooks County

Location

Rig up

Drilling and Remarks:

Loss 3/9/Dr 43472

RECORD

Cased _____ in., _____ ft.

Sand _____

Gas _____

Oil _____

Total Depth 8500

PRODUCTION

1st 24 hrs. Nat. _____

1st 24 hrs. after shot _____

Gas _____ Cu. Ft.

Dry Hole _____

Abandoned _____

Date

DEC 15 1948

19

S. J. LEWIS

Scout