

Sec. 14 Twp. 9 R. 19-W

Well No. #5 Boisvert Farm

Phillips Petroleum Company

Chandler Contractor


_____ Ft. from N. Line

1662 Ft. from S. Line

330 Ft. from E. Line

_____ Ft. from W. Line

SE NE SE

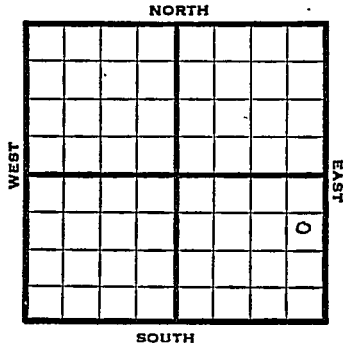

1950

Elev. 2095' REPORT

11/1

Location

1951

1/24

Spud 11-27-50

Oil Well TD 3513

Anhy 1463' 8" @ 1510

Howard 3017' Top. 3042'

Heeb. 3223' Toronto 3245'

Lans. 3263' Arb. 3503

TD 3513' 5" @ 3505

FU 1200' oil S/93 bo 2 hr

S/39 boph 500 A Draw down pot.

3000 bopd

COMPLETED

