


Section 14 Township 9 Range 19-W

Well No. #6 Boisvert

Company Phillips Petroleum *15*

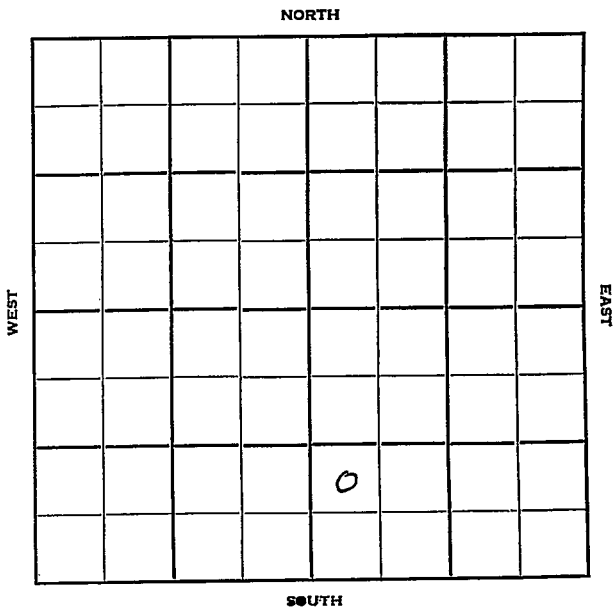

Sec. \_\_\_\_\_ Twp. \_\_\_\_\_ R. \_\_\_\_\_

Well No. #6 Boisvert Farm \_\_\_\_\_

Phillips Petroleum Company

Phillips Pet. Contractor

Chandler


\_\_\_\_\_ Ft. from N. Line

990 Ft. from S. Line

\_\_\_\_\_ Ft. from E. Line

330 Ft. from W. Line

NW SW SE

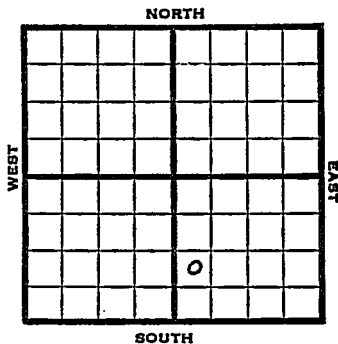

1951 Elev. 2081' REPORT

1/10 RUR  
3/14 Spud 1-9-51  
Oil Well TD 3511  
8" @ 1495'  
Howard 3012 Top 3038'  
Heeb. 3219' Toronto 3240  
Lans. 3261 BKG 3455  
Arb. 3490  
TD 3496  
5" @ 3492 FU 150' oil DD 3511  
S/31 bo 1 hr 38 bo 2nd hr.  
Comp. 127 bopd 1 bw

**COMPLETED**



