

Section 14 Township 9 Range 19WWell No. #1 Chem-KabaCompany Phillips Pet. 13

NORTH

WEST

EAST

SOUTH

Rooks

KANSAS

Sec. 14 Twp. 9 R. 19 W

Well No. # 1 Chem - Kaba Farm

Phillips Pet. Company

B & R Drlg. Contractor


 Ft. from N. Line

990 Ft. from S. Line

 Ft. from E. Line

990 Ft. from W. Line

NE SW SW

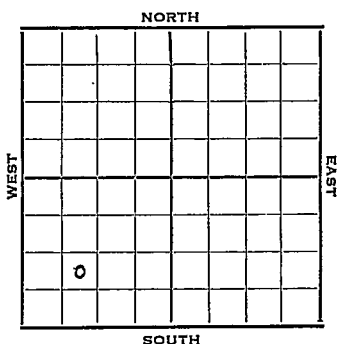

1951 Elev. 2086' REPORT

12/5 RUR

1952

1/16

Spud 12-6-51

Oil Well TD 3506'

8" @ 189'

Howard 3016 Top. 3043

Heeb. 3221 Tor. 3240

Lans. 3260 B KC 3469

Arb. 3498 TD 3500

5" @ 3499 CO to 3500 E/ 1/4 BOPH

DD 3506 500 A S/ 14 BOPH

Comp. 228 BOPD

COMPLETED



Operator Phillips Pet.

Well No. 1 Farm Chem - Kaba

Elev.	2086	Location	NE SW SW
-------	------	----------	----------

0

COMPLETE

990 Ft. From S Line SW

990 Ft. From W Line Quarter

1st. Report

Completion JAN 16 1952

Remarks

B & R Drlg. - Contr.

Spudding Date 12-6-51

Drilg. Data Oil well TD 3506

8" @ 189 Howard 3016 Top. 3043

Heeb. 3221 Tor. 3240 Lans. 3260

B KC 3469 Arb. 3498 TD 3500

5" @ 3499 CO to 3500 B/ $\frac{1}{4}$ boph

DD 3506 500 A S/ 14 boph

Comp. 228 bopd

J. E. TYRA