

Section 14 Township 9 Range 19W

Well No. #7 Boisvert

Company Phillips

*16*

NORTH

WEST

EAST

							6

SOUTH

Rooks

Sec. 14 Twp. 9 R. 19W

Well No. #7 Boisvert Farm

Phillips Company

Phillips - Contr. Contractor  
Chandler


\_\_\_\_\_ Ft. from N. Line

330' Ft. from S. Line

330' Ft. from E. Line

\_\_\_\_\_ Ft. from W. Line

SE SE SE

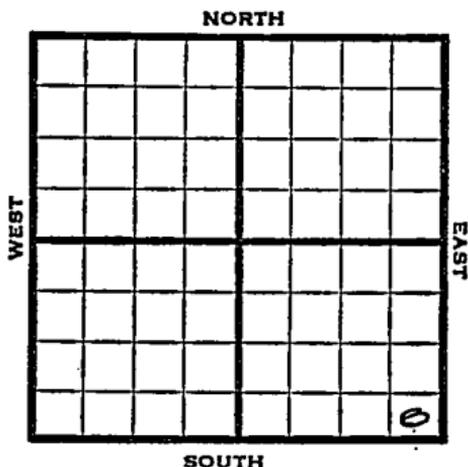

1952 Elev. 2101' REPORT

2/6 Spud 2-2-52  
8" @ 218  
Drlg. 2120'

2/13 Howard 3021 Topeka 3046  
Heeb. 3228 Tor 3349  
Lans. 3270 BKG 3476  
Arb. 3513 TD 3516  
5" @ 3514

2/20 DP CO to 3516' Fill up 2500' oil  
S/115 BO in 2 hrs. POP

3/5 Spud 2-2-52  
Oil Well TD 3516  
8" @ 218 Howard 3021 Top 3046  
Heeb. 3228 Tor. 3249 Lans. 3270  
BKG 3476 Arb. 3513 TD 3516  
5" @ 3514 CO to 3516 FU 2500' oil  
S/115 bo 2 hr. Comp. 3000 bopd

**COMPLETED**



