


Section 14 Township 9 Range 19W

Well No. 1 Kaba

Company Phillips

Chandler Pool  
NORTH

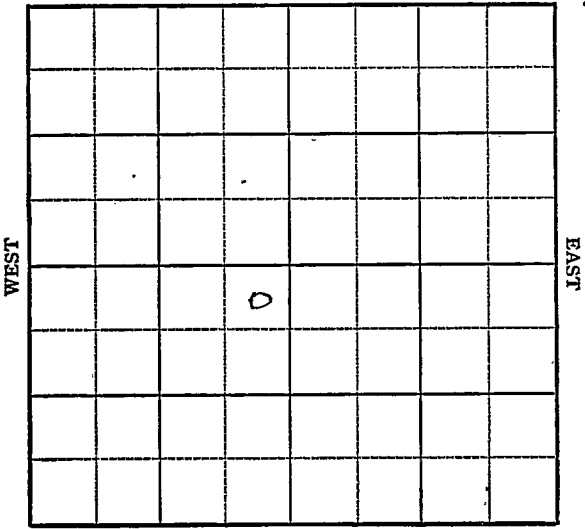

**KANSAS**

Rooks

Sec. 14 Twp. \_\_\_\_\_ R. 19W

Well No. #1 Kaba Farm \_\_\_\_\_

Phillips Company


Chandler Pool

330' Ft. from N. Line

\_\_\_\_\_ Ft. from S. Line

330' Ft. from E. Line

\_\_\_\_\_ Ft. from W. Line

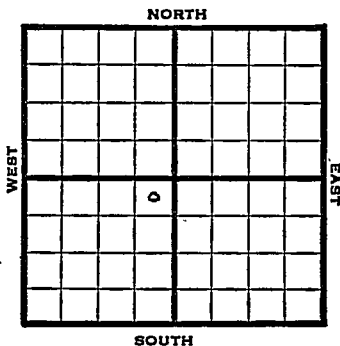

NE SW

1948	Elev. 2053' REPORT
8/18	Location
8/25	Drlg 1125'
9/1	Drlg. 2815 ' 8" @ 1472'
9/8	Lansing 3225 ' Arb. 3462 ' Drlg 3471'
9/14	3498 SO
9/21	TD 3535 ' 5" @ 3478'
9/29	"
10/6	TD 3498 ' Swb 283' bbls oil 12 hrs.
10/13	"
10/19	Pump 148 bbls oil 13 hrs. 18% GS
10/26	"
11/3	"
11/10	"
11/17	Arb 3462 ' 5" @ 3475 ' 500 acid Echo Pot. 2044 oil & 611 Water Gr. 27.5 TD 3535'

**COMPLETED**

Rooks County Kansas State

Map No. \_\_\_\_\_ Sec. 14 Twp. 9 R. 19<sup>W</sup>

Well No. 1 Kaba

Phillips Company

**FIRST REPORT**

Contractor \_\_\_\_\_

NE SW

**SECTION PLAT**


330 Ft. from N. Line

\_\_\_\_\_ Ft. from S. Line

330 Ft. from E. Line

\_\_\_\_\_ Ft. from W. Line

**Chandler Pool**

Remarks:

Location

Date  
AUG 18 1948

Scout S. J. LEWIS

Map No. 65 Sec. 14 Twp. 9 R. 19W

Well No. 1 Kaba

Phillips Company

**COMPLETE**

Contractor

NE SW

*E1,2003*

**SECTION PLAT**

330 Ft. from N. Line

\_\_\_\_\_ Ft. from S. Line

330 Ft. from E. Line

\_\_\_\_\_ Ft. from W. Line

	△		

Rooks County

Location \_\_\_\_\_

Rig up \_\_\_\_\_

Drilling and Remarks:

*Cor 3462*  
*5" @ 3475'*  
*500 acid*  
*Ech log 2044 oil*  
*+ 611 Water*  
*275 gr*

**RECORD**

Cased \_\_\_\_\_ in., \_\_\_\_\_ ft.

Sand \_\_\_\_\_

Gas \_\_\_\_\_

Oil

Total Depth 3535'

**PRODUCTION**

1st 24 hrs. Nat. \_\_\_\_\_

1st 24 hrs. after shot \_\_\_\_\_

Gas \_\_\_\_\_ Cu. Ft.

Dry Hole \_\_\_\_\_

Abandoned \_\_\_\_\_

Date

NOV 17 1948 19

S. J. LEWIS

Scout