


Section 14 Township 9 Range 19-W

Well No. #2 Kaba

Company Phillips
Chandler Pool

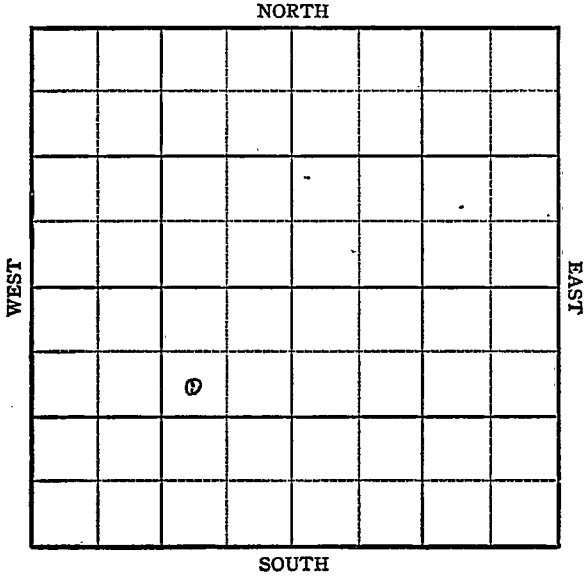

Sec. 14 Twp. 9 R. 19-W ✓

Well No. #2 Kaba Farm

Phillips Company


Chandler

990 Ft. from N. Line

_____ Ft. from S. Line

990 Ft. from E. Line

_____ Ft. from W. Line

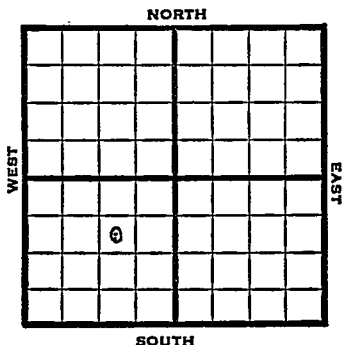

SW NE SW

1948		REPORT
	Eli 2078'	
10/13	Drlg 350	
10/19	8" @ 1472'	
	Drlg 2435'	
10/27	Lansing 3250'	
	Drlg 3458'	
11/3	Arbuckle 3488'	
	TD 3490'	
	5" @ 3487'	
	Swb 3 bbls oil - 4 hrs.	
11/10	"	
11/16	"	
11/23	"	
11/30	500 acid	
	Pump 196 bbls oil 21 hrs	
12/8	1000 acid	
12/15	TD 3490'	
	Arb 3488'	
	5" @ 3489'	
	1500 acid	
	Echo Pot 1323 Oil	
	28° Gr.	
	Comp	
	COMPLETED	

Map No. _____ Sec. 14 Twp. 9 R. 19W

Well No. 2 Kaba

Phillips Company

FIRST REPORT Contractor

SW NE SW

SECTION PLAT

990 Ft. from N. Line

_____ Ft. from S. Line

990 Ft. from E. Line

_____ Ft. from W. Line

Rooks County

Location _____

Rig up _____

Drilling and Remarks:

drlg. 350

RECORD

Cased _____ in., _____ ft.

Sand _____

Gas _____

Oil _____

Total Depth _____

PRODUCTION

1st 24 hrs. Nat. _____

1st 24 hrs. after shot _____

Gas _____ Cu.-Ft.

Dry Hole _____

Abandoned _____

Date

OCT 13 1948 19

S. J. LEWIS Scout

Map No. 5 Sec. 14 Twp. 9 R. 19W

Well No. 2 Kaba

Phillips Company

COMPLETE Contractor

SW NE SW

E12078

SECTION PLAT

990 Ft. from N. Line

_____ Ft. from S. Line

990 Ft. from E. Line

_____ Ft. from W. Line

	0		

Rooks County

Location _____

Rig up _____

Drilling and Remarks:

Case 3488
5" @ 3489
1500 acid
Echm Pat 182302

250 92

RECORD

Cased _____ in., _____ ft.

Sand _____

Gas _____

Oil

Total Depth 3490

PRODUCTION

1st 24 hrs. Nat. _____

1st 24 hrs. after shot. _____

Gas _____ Cu. Ft.

Dry Hole _____

Abandoned _____

Date

DEC 15 1943

19

S. J. LEWIS

Scout