

Section 14 Township 9 Range 19W

Well No. 3 Landry



Company Phillips

Chandler Pool

NORTH

			0				

WEST

EAST

SOUTH

Sec. 14 Twp. 9 R. 19-W ✓


Well No. #3 Landry Farm
Phillips Company
Ghandler

990 Ft. from N. Line

_____ Ft. from S. Line

330 Ft. from E. Line

_____ Ft. from W. Line

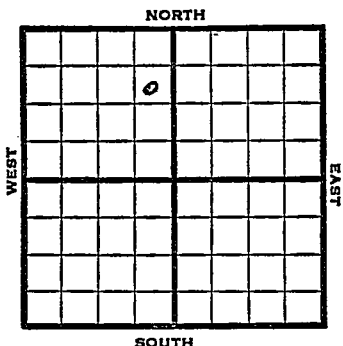

SE NE NW

1948 Elev. 2057' REPORT

11/3	Drlg 1252'
11/10	8" @ 1478' Drlg. 2565'
11/16	Lansing 3233' Drlg. 3409'
11/23	Arb. 3475' TD 3478' 5" @ 3475'
11/30	"
12/8	500 acid Swb 184 bbls oil 2¼ hrs.
12/15	Pump 278 bbls oil 15 hrs.
12/22	Arb 3475' 5" @ 3475' 500 acid Echo Pot. 3000 oil Gr. 28° TD 3478' COMPLETED

Map No. _____ Sec. 14 Twp. 9 R. 19W

Well No. 3 Landry

Phillips Company

FIRST REPORT Contractor

SE NE NW

SECTION PLAT

990 Ft. from N. Line

_____ Ft. from S. Line

330 Ft. from E. Line

_____ Ft. from W. Line

	o		

Rooks County

RECORD

Location _____

Cased _____ in., _____ ft.

Rig up _____

Sand _____

Drilling and Remarks: _____

Gas _____

Oil _____

drlg. 1252

Total Depth _____

PRODUCTION

1st 24 hrs. Nat. _____

1st 24 hrs. after shot _____

Gas _____ Cu. Ft.

Dry Hole _____

Abandoned _____

Date

NOV 3 1948 19

S. J. LEWIS Scout

Kansas

Map No. 65 Sec. 14 Twp. 9 R. 19W

Well No. 3 Landry

Phillips

Company

COMPLETE

Contractor

SE NE NW

E 1,2057

SECTION PLAT

990 Ft. from N. Line

_____ Ft. from S. Line

330 Ft. from E. Line

_____ Ft. from W. Line

Rooks County

Location _____

Rig up _____

Drilling and Remarks:

Cor 3475
5" 02475
500 acid
Echo Port 3000 oil
2800

RECORD

Cased _____ in., _____ ft.

Sand _____

Gas _____

Oil

Total Depth 3425

PRODUCTION

1st 24 hrs. Nat. _____

1st 24 hrs. after shot _____

Gas _____ Cu. Ft.

Dry Hole _____

Abandoned _____

Date

DEC 22 1948 19

S. J. LEWIS

Scout