

KANSAS


Rooks

Section 14 Township 9 Range 19W

Well No. 4 Landry

Company Phillips

Chandler
NORTH

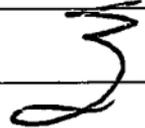

WEST

EAST

		0					

SOUTH

Sec. 14 Twp. 9 R. 19W


Well No. #4 Landry Farm

Phillips

Company

Chandler Pool

990' Ft. from N. Line

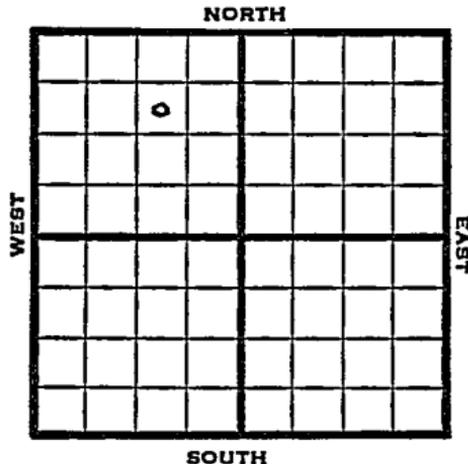

_____ Ft. from S. Line

990' Ft. from E. Line

_____ Ft. from W. Line

SW NE NW-

1949 Elev. 2054' DF REPORT

8/31 Location

9/6 Drlg. 1325'

9/14 8" @ 1489'
Lansing 3236'
Drlg 3270'

9/21 BKC 3444' Arbuckle 3476'
5" @ 3478'
TD 3480'
Swb 8 bbls oil 1/3 hr.

9/28 "

10/5 "

10/12 TD 3483'

10/19 "

10/26 Arb 3476'
5" @ 3478'
Pump 153 oil & 8% W Pot.
Grav. 28°
TD 3483'

COMPLETED

Kansas

Map No. _____ Sec. 14 Twp. 9 R. 19W

Well No. 4 Landry

Phillips

Company

Contractor

SW NE NW

FIRST REPORT
SECTION PLAT

990 Ft. from N. Line

_____ Ft. from S. Line

990 Ft. from E. Line

_____ Ft. from W. Line

	o		

Rooks County

Location X

Rig up _____

Drilling and Remarks:

RECORD

Cased _____ in., _____ ft.

Sand _____

Gas _____

Oil _____

Total Depth _____

PRODUCTION

1st 24 hrs. Nat. _____

1st 24 hrs. after shot _____

Gas _____ Cu. Ft.

Dry Hole _____

Abandoned _____

Date

AUG 31 1949 19

S. J. LEWIS

Scout

Kansas

Map No. _____ Sec. 14 Twp. 9 R. 19WWell No. 4 Laundry

Phillips

Company

COMPLETE

Contractor

SW NE NW

E 12054
SECTION PLAT990 Ft. from N. Line

_____ Ft. from S. Line

990 Ft. from E. Line

_____ Ft. from W. Line

Rooks County

Location _____

Rig up _____

Drilling and Remarks:

*Cr 43476**5" @ 3478**Run 1530 ft 7 8 9 10 W**PS**28 1/2 ft*

RECORD

Cased _____ in., _____ ft.

Sand _____

Gas _____

Oil _____

Total Depth 3473

PRODUCTION

1st 24 hrs. Nat. _____

1st 24 hrs. after shot _____

Gas _____ Cu. Ft.

Dry Hole _____

Abandoned _____

Date

QCT 26 1949

19

S. J. LEWIS

Scout