


Section 14 Township 9 Range 19W

Well No. #6 Landry

Company Phillips Petroleum

NORTH

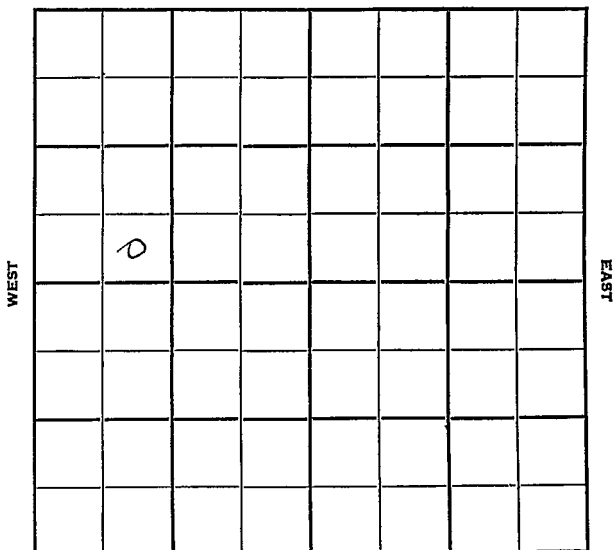

SOUTH

Rooks

KANSAS

Sec. 14 Twp. 9 R. 19W

Well No. #6 Landry Farm

Phillips Petroleum Company

Phillips - Contr. Contractor

Chandler Pool


 Ft. from N. Line

330' Ft. from S. Line

 Ft. from E. Line

990' Ft. from W. Line

SE SW NW

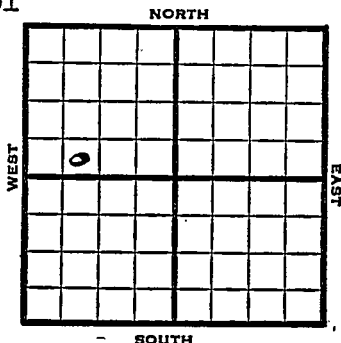

1951

Elev. 2063' REPORT

1/24

RUR

3/21

Spud 1-25-51

Oil Well TD 3493

Anhy 1430 8" @ 1479-

Howard 3001 Top 3026 -

Heeb. 3206 Toronto 3226'

Lans. 3247 Arb. 3485

5" @ 3485 $\frac{1}{2}$ TD 3493

S/46 BOPH 500 A

Comp. draw down pot. 2560 bopd

285 bwpd

COMPLETED

County Rooks State Kansas

Sec. 14 (Blk.) 9 (Sur.) 19W Map No.
(Twp.) (Rge.)

Operator Phillips Petroleum

Well No. ' 6 ' Farm Landry

Elev.	2063	Location	SE SW NW
-------	------	----------	----------

o

FIRST REPORT

330 Ft. From S Line NW

990 Ft. From W Line Quarter

1st. Report **JAN 24 1954**

Completion

Remarks:

Phillips - Contr.


Spudding Date: _____

Drlg. Data Chandler Pool

R U R

J. E. TYRA

County _____ Rooks _____ State Kansas
 Sec. 14 (Blk. Twp.) 9 (Sur. Rge.) 19 W Map No. _____
 Operator Phillips Petroleum
 Well No. 6 Farm Landry
 Elev. 2063 Location SE SW NW

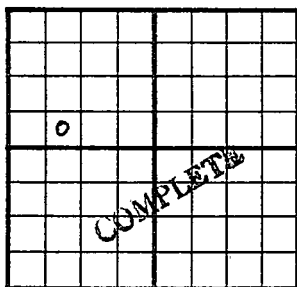

330 Ft. From S Line NW
 990 Ft. From W Line Quarter

Ist. Report _____

Completion MAR 21 1951

Remarks Chandler Pool

Phillips - Contr.

Spudding Date 1-25-51

Drlg. Data _____ Oil well _____ TD 3493

Anhy 1430 8" @ 1479 Howard 3001

Top. 3026 Heeb. 3206 Toronto 3226

Lans. 3247 Arb. 3485 5" @ 3485 $\frac{1}{2}$

TD 3493 S/ 46 boph 500 A

Comp. draw down 'pot. 2560 bopd 285 bwpd

J. E. TYRA