

Rooks

Section 14 Township 9 Range 19WWell No. #8 LandryCompany Phillips Oil Co.

NORTH

0							

WEST

EAST

SOUTH

Sec. 14 Twp. 9 R. 19 W

Well No. # 8 Landry Farm

Phillips Oil Co. Company

Phillips Contractor

Chandler


640 Ft. from N. Line

_____ Ft. from S. Line

_____ Ft. from E. Line

330 Ft. from W. Line

C W/2 NW NW

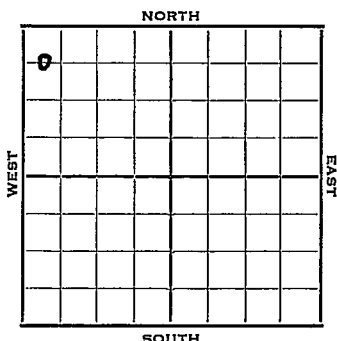

1952 Elev. 2059' REPORT

6/18 Spud 6-15-52
8" @ 213 WOC

6/25 Schl tops: Tarkio 2996', Topeka 3021'
Heeb 3201' Tor 3221' Lans. 3241'
B KC 3459' Arb. 3482'
TD 3488'

7/2 5" @ 3482 CO 3488 2000' oil 35 mins
POP

7/9 NR

7/16 Spud 6-15-52
Oil well TD 3488' 8" @ 213
Anhy 1440' Tarkio 2996' Top 3021'
Heeb 3201' Tor. 3221' Lans. 3241'
B KC 3459' Arb. 3482'
TD 3488' 5" @ 3482 CO to 3488
FU 2000' oil 35 min.
Comp. 90 BOPD 360 BW

COMPLETED

County Rooks State Kansas
 Sec. 14 (Blk.) 8 (Sur.) 198 Map No.
 Operator Phillips Oil Co.
 Well No. 8 Farm Landry
 Elev. _____ Location C W/2 NW NW

0							

FIRST REPORT

640 Ft. From N Line NW
330 Ft. From N Line Quarter
 Ist. Report JUN 18 1952

Completion _____

Remarks _____

Phillips - Contr.

Spudding Date 6-15-52


Drlg. Data _____

Chandler

8" @ 213 WOC

J. G. McGEHEE

County _____ Rooks _____ State Kansas
 Sec. 14 (Blk. Twp.) 9 (Sur. Rge.) 19W Map No. _____
 Operator Phillips Pet.
 Well No. 8 Farm Landry
 Elev. 2059 Location C W L NW NW

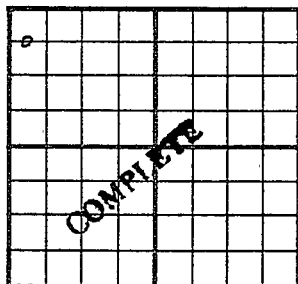

640 Ft. From N Line NW
330 Ft. From W Line Quarter
 1st. Report _____
 Completion JUL 16 1952
 Remarks Chandler Pool
Phillips - Comtr.
 Spudding Date 6-15-52

Drilg. Data Oil well TD 3488
8" @ 213 Anhy 1440 Tarkio 2996
Top. 3021 Heeb. 3201 Tor. 3221
Lens. 3241 B KC 3459 Arb. 3482
TD 3488 5" @ 3482 CO to 3488
FU 2000' oil 35 min.
Comp. 90 bopd 360 bw

J. G. McGEHEE