

Company Harry Gore

NORTH

WEST

EAST

SOUTH

Sec. 14 Twp. 9 R. 19W

Well No. #9 Ruder Farm

Harry Gore Company

Empire Drlg. Contractor


 Ft. from N. Line

990' Ft. from S. Line

990' Ft. from E. Line

 Ft. from W. Line

NW SE NE

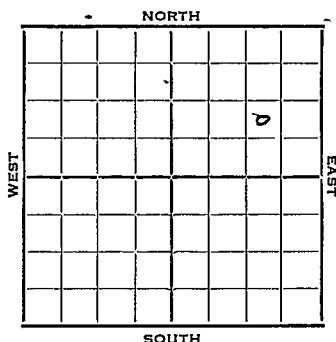

1952	Elev. 2068'	REPORT
4/16	Drlg. 865'	
4/23	Drlg. 2665'	
4/30	Anhy 1430 Topeka 3995 Heeb. 3201 Dodge 3220 Lans. 3236 DST 3280-85 3/4 hr. 325' MCO 1100# DST? 3420 3/4 hr. 510' muddy SW 1020# Arb. 3481-84 RTD 5" @ 3482 WOG	
5/7	Cor. DST 3221-67 3/4 hrs. 365' OCM 1100# DST 3390-3418 3/4 hrs. 310' wtr. & scum oil 1020# DST 3409-18 3/4 hrs. 220' SW 1020 # Rung log & to perf Lans.	
5/14	Perf ?/3410-16 2000 A S/9 BFPH for 5 hrs. 50# water. Set plug 3400' ?/3220-24 3000 A S/30 BOPH for 3 hrs.	
5/21	NR	
5/28	NR	
6/11	Oil well TD 3484' Anhy 1430' 8" @ 1440 Top 2995' Heeb 3201' Dodge 3220' Lans. 3236' DST 3280-85 open 3/4 hr. rec 325' MCO DST ? - 3420 open 45 min, rec 510' muddy SW.	

OVER

1952
6/11


(Information continued)

Arb. 3481' 5" @ 3482 TD 3484'
DST 3221-67 open 3/4 hr. rec 365' OC^M
DST 3390-3418 open 3/4 hr. rec 310'
water & scum oil.
DST 3409-18 open 3/4 hr. rec 270' SW
Perf 3410-16 2000 A S/9 BFPH
50% water. SP 3400 Perf/3220-24
3000 A S/30 BOPH
Comp. 97 BOPD 42% water.

COMPLETED

J. G. McGEHEE

County _____ Rocks _____ State Kansas
 Sec. 14 (Blk. 9) (Sur. 19W) Map No. _____
 Operator Harry Gore
 Well No. 9 Farm Ruder
 Elev. 2068 Location NW SE NE

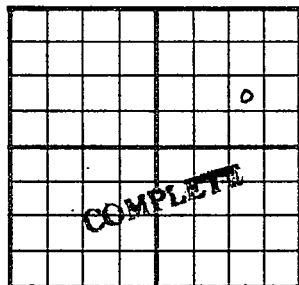

990 Ft. From S Line NE
990 Ft. From E Line Quarter
 1st. Report _____
 Completion JUN 11 1952
 Remarks _____
Empire Drlg. - Contr.
 Spudding Date _____

Drlg. Data Oil well TD 3484
Anhy 1430 8" @ 1440 Top. 2995
Heeb. 3201 Dodge 3220 Lans. 3236
DST 3280-85 open 3/4 hr. Rec. 325' mco
DST ? - 3420 open 45 min. Rec. 510'
muddy sw Arb. 3481 5" @ 3482 TD 3484
DST 3221-67 open 3/4 hr. Rec. 365' ocm
DST 3390-3418 open 3/4 hr. Rec. 310'
water & scum oil DST 3409-18 open
3/4 hr. Rec. 270' sw Perf/ 3410-16
2000 A S/ 9 bfph 50% water SP 3400
Perf/ 3220-24 3000 A S/ 30 boph
Comp. 97 bopd 42% water

J. G. McGEHEE