KANSAS
FORM 51 5M 10-41 PETROL


Rooks

Section 14 Township 9 Range 20-W

Well No. #1 Coulter

Company Helmerich & Payne

Wildcat

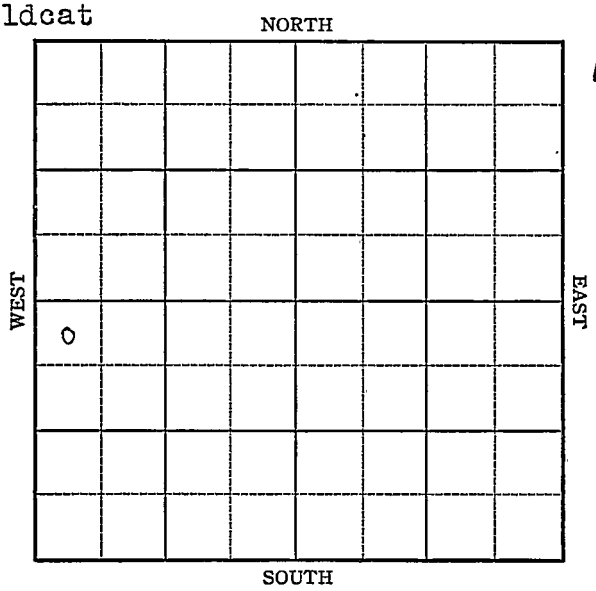

12

FORM 252-A
5M 9-42 GASS

KANSAS Rooks

Sec. 14 Twp. 9 R. 20-W

Well No. #1 Coulter Farm

Helmerich & Payne Company


(Wildcat)

330 Ft. from N. Line

_____ Ft. from S. Line

_____ Ft. from E. Line

330 Ft. from W. Line

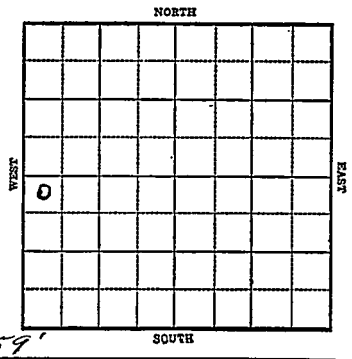

Elev 2159'

1942	REPORT
10/7	Location
10/14	10" @ 126' WOC
10/21	Anhy 1637 Drlg 2830
10/28	Láns. 3353 Congl. 3671 Arb. 3677 No shows T.D. 3775'

ABANDONED

Form 26 200 Bks 5-42 Petrol

Rooks

Map No. 65 Sec. 14 Twp. 9 R. KANSAS 20W

Well No. 1 Coulter

Helmerich & Payne Company

FIRST REPORT Contractor

NW SW


330 Ft. from N. Line

_____ Ft. from S. Line

_____ Ft. from E. Line

330 Ft. from W. Line

SECTION PLAT

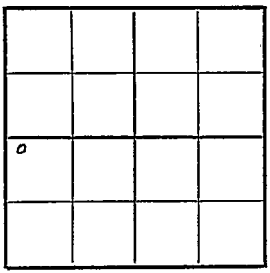

WILDCAT

Location XXX

Rig up

Drilling and Remarks:

RECORD

Cased ____ in., ____ ft.

Sand

Gas

Oil

Total Depth

PRODUCTION

1st 24 hrs. Nat.

1st 24 hrs. after shot

Gas ____ Cu. Ft.

Dry Hole

Abandoned

Date

OCT 7 1942 19

S. J. LEWIS Scout

Form 26 200 Bks 5-42 Petrol Rooks KANSAS

Map No. 65 Sec. 14 Twp. 9 R. 20W

Well No. 1 Coulter

Helmerich & Payne Company

ABANDONED Contractor

NW SW

330 Ft. from N. Line


____ Ft. from S. Line

____ Ft. from E. Line

330 Ft. from W. Line

WILDCAT

SECTION PLAT

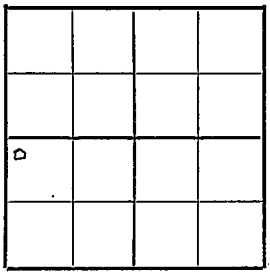

Location ____

Rig up ____

Drilling and Remarks:

Lans 3353
Congl 3671
Ck 3677
Noskowe

RECORD

Cased ____ in., ____ ft.

Sand ____

Gas ____

Oil ____

Total Depth 3775

PRODUCTION

1st 24 hrs. Nat. ____

1st 24 hrs. after shot ____

Gas ____ Cu. Ft.

Dry Hole ____

Abandoned ____

Date

OCT 28 1942 19 S. J. LEWIS Scout